

WILLIAM E. HAMMOND ZONING COMMISSIONER

July 20, 1981

Mr. Charles E. Fick George William Stephens, Jr. and Associates, Inc. 303 Allegheny Avenue P. O. Box 6828 Towson, Maryland 21204

RE: Xtra Corporation Site Expansion (Case No. 66-96-X and Case No. 80-9-X)
Three Acres Old North Point Road 15th Election District

Dear Mr. Fick:

Reference is made to your letter of May 13, 1981, requesting verification that the remaining three acres of the overall tract granted a Special Exception by Case No. 36-96-X can be expanded in accordance with the same criteria set forth in Case No. 80-9-X.

Please be advised that I have discussed this matter with Mr. William E. Hammond, the Zoning Commissioner, and we are both of the opinion that the remaining three acres can be considered for expansion in the same manner as the two acre expansion petitioned for by Case No. 80-9-X.

If you have any additional questions or if I can be of any further assistance in this matter, please do not hesitate to contact me.

Very truly yours,

JAMES E. DYER Zoning Supervisor

JED:nr

cc: Mr. William E. Hammond Zoning Commissioner

Mrs. Jean M. H. Jung Deputy Zoning Commissioner

Case No. 80-9-X

LAW OFFICES

CARDIN and WEINSTEIN, P. A. 6615 REISTERSTOWN ROAD BALTIMORE, MARYLAND 21215 (301) 358-7411

TOWSON, MD. OFFICE 40 W. CHESAPEAKE AVE. SUITE 500 TOWSON, MD. 21204 (301) 337-7603

WASHINGTON, D. C. OFFICE 1025 CONNECTICUT AVE.,N.W. SUITE 911 WASHINGTON, D.C. 20036 (202) 466-8010

JEROME S. CARDIN WILLIAM I. WEINSTEIN LAWRENCE K. GINSBERG HOWARD C. WEINSTEIN DAVID A. KUNTZ

The same of the sa

ARNOLD FLEISCHMANN MARK B. SANDGROUND® JACOB L. CARDIN

EMEMBER D.C. BAR

DECEMBER 4, 1980

COUNTY BOARD OF APPEALS ROOM 219 COURT HOUSE TOWSON, MARYLAND 21204

RE: CASE NO. 80-9-X SOUTHWEST SIDE OF NORTH POINT ROAD X-L CO., INC. GRANOKE PROPERTIES

#### GENTLEMEN:

PLEASE EXCUSE MY DELAY IN GETTING BACK TO YOU REGARDING THE ABOVE CAPTIONED CASE, BUT I HAVE HAD DIFFICULTY CONTACTING MY CLIENT IN BOSTON.

THE PURPOSE OF THIS LETTER IS TO ADVISE YOU OF THE LANGUAGE TO BE INCORPORATED IN YOUR ORDER IN THE ABOVE CAPTIONED CASE.

THE PETITIONERS HAVE APPEALED THE ZONING COMMISSIONER'S ORDER AND, SPECIFICALLY, PARAGRAPHS 4 AND 6 APPEARING ON THE LAST PAGE OF HIS ORDER, DATED FEBRUARY 6, 1980. THE LANGUAGE OF PARAGRAPH 4 SHOULD BE CHANGED AND INCORPORATED IN THE BOARD'S ORDER AS FOLLOWS:

THAT THERE WILL BE ESTABLISHED A 25 FOOT SETBACK FROM THE PROPERTY LINE ALONG NORTH POINT ROAD, WHEREIN NO STACKING OF CONTAINERS SHALL OCCUR.

THAT THERE WILL BE ESTABLISHED A 30 FOOT SETBACK FROM THE PROPERTY LINE ALONG THE SOUTH SIDE OF THE PROPERTY, WHEREIN NO STACKING OF CONTAINERS SHALL OCCUR.

THAT THERE WILL BE ESTABLISHED A 20 FOOT SETBACK FROM THE PROPERTY LINE ON THE REMAINING PERIMETER WHEREIN STACKING OF CONTAINERS SHALL BE ALLOWED TO A HEIGHT OF 17 FEET.

IN ALL OTHER AREAS, STACKING OF CONTAINERS SHALL BE ALLOWED TO A HEIGHT OF 26 FEET.

THE LANGUAGE OF PARAGRAPH 6 SHOULD BE CHANGED TO READ THAT THE PICKUP AND DELIVERY OF CONTAINERS, CHASSIS, AND TRAILERS, SHALL OCCUR BETWEEN THE HOURS OF 8:00 A.M. AND 6:00 P.M.

Cardin and Weinstein, P.A.

COUNTY BOARD OF APPEALS DECEMBER 4, 1980

FURTHER, THAT ONLY REPAIRS OF A MINOR NATURE SHALL BE PERFORMED AT THE FACILITY. THANKING YOU FOR YOUR CONTINUING COOPERATION IN THIS MATTER, AND AWAITING YOUR FINAL ORDER, I AM.

VERY TRULY YOURS.

LAWRENCE K. GINSBERG ATTORNEY FOR PETITIONERS

CC; PETER N. ZIMMERMAN, ESQUIRE DEPUTY PEOPLE'S COUNSEL

EV/NS & GEORGE

Cardia and Weinstein, P.A.

COUNTY BOARD OF APPEALS DECEMBER 4, 1980 PAGE 2

FURTHER, THAT DNLY REPAIRS OF A MINOR NATURE SHALL BE PERFORMED AT THE FACILITY. THANKING YOU FOR YOUR CONTINUING COOPERATION IN THIS MATTER, AND AWAITING YOUR

FINAL ORDER, I AM. VERY TRULY YOURS,

LAWRENCE K. GINSBERG ATTORNEY FOR PETITIONERS

CC: PETER N. ZIMMERMAN. ESQUIRE DEPUTY PEOPLE'S COUNSEL

BALTIMOSE COUSTY

DEC 4 3 40 PM 'BE

COUNTY SALS

OF A STREATS

FROM THE OFFICE OF GEURGE WILLIAM STEPHENS, JR. & ASSOCIATES, INC ENGINEERS 303 ALLEGHENY AVENUE, TOWSON, MARYLAND 21204

February 13, 1979

Description to Accompany Zoning Petition for Special Exception to Ammend Approved Plans for Existing Truck Terminal to Include Expansion of Site Area and Addition to Existing Office Building Xtra Corporation-4035 Old North Point Road

Beginning for the same at the end of the two following courses viz: first, commencing at a point on the southwest side of Old North Point Road 40 feet wide, said point being the southeast side of Battle Grove Road 40 feet wide and running thence along the southwest side of Old North Point Road southeasterly 446 feet more or less and second, leaving said road South 66° 00' 41" West 289 feet more or less to said place of beginning, running thence the two following courses viz: (1) South 47° 39' 56" East 614.13 feet and (2) North 50° 57' 20" East 186.22 feet to the southwest side of Old North Point Road, thence binding thereon (3) South 39° 02' 40" East 93.75 feet, thence leaving said road the three following courses viz: (4) South 50° 57' 20" West 150.00 feet, (5) South 39° 02' 40" East 50.00 feet and (6) North 54° 21' 33" East 148.48 feet to the southwest side of said Old North Point Road, thence binding thereon (7) southeasterly by a curve to the right having a radius of 939.04 feet and a distance of 439.22 feet, thence leaving said road and running the four following courses viz: (8) South 66° 22' 40" West 118.80 feet, (9) North 47° 44' 10" West 543.58 feet, (10) North 47° 39' 56" West 653.98 feet and (11) North 66° 09' 41" East 150 21 feet to the place of beginning.

Containing 5.000 acres of lard more or less.

The herein above described 5.000 acre parcel being a part of that 8 acre tract of land having been granted a special exception for a truck terminal file. Case No. 66-96-X.

LKG/ER

Cardin and Weinstein, P. A. ATTORNEYS AT LAW SUITE 301

JERGME S CARDIN WILLIAM E WEINSTEIN LAWRENCE K. GINSBERG HU MARD C. WEINSTEIN MICHAEL D. VOGELSTEIN

LAW OFFICES

CARDIN and WEINSTEIN, P. A.

6615 REISTERSTOWN ROAD SUITE 301

BALTIMORE, MARYLAND 21215 (301) 358-7411

TOWSON, MD. OFFICE

TOWSON, MD, 21204

(301) 337-7603

SUITE 500

40 W CHESAPEAKE AVE.

JANUARY 19, 1981

COUNTY BOARD L APPEALS

TOWSON, MARYLAND 21204

SOUTHWEST SIDE OF NORTH POINT

PETITIONERS

X-L CO., INC. AND GRANOKE PROPERTIES

ALL REQUESTED INFORMATION HAS BEEN FORWARDED TO THE BOARD.

ROOM 219 COURT HOUSE

FE: CASE NO. 80-9-X

ORDER CAN BE EXPECTED.

DO NOT HESITATE TO CONTACT ME.

GENTLEMEN:

MATTER, I AM,

VERY TRULY YOURS,

LAWRENCE K. GINSBERG ATTORNEY FOR PETITIONERS

CC; MR. DENNIS BAKER

X-L CO., INC.

WASHINGTON, D. C. OFFICE

WASHINGTON, D.C. 20036

(202) 466-8010

Suit€ 911

1025 CONNECTICUT AVE., N. W.

I HAVE HAD NUMEROUS INQUIRIES FROM MY CLIENTS REGARDING WHEN A FINAL OPINION

IS TO BE RENDERED IN THE ABOVE CAPTIONED CASE. IT HAS BEEN SOME TIME SINCE

I WOULD APPRECIATE YOUR ADVISING THE STATUS OF THE OPINION AND WHEN THE FINAL

IF THERE IS ANYTHING FURTHER THAT I MIGHT DO TO EXPEDITE THIS MATTER, PLEASE

THANKING YOU FOR YOUR IMMEDIATE ATTENTION AND CONTINUING COOPERATION IN THIS

6615 REISTERSTOWN ROAD BALTIMORE, MARYLAND 21215

BALTIN 395 701 11748


JACOB L CARDIN

OF COUNSEL

(301) 358-7411

JEROME S CARDIN

WILLIAM I. WEINSTEIN

LAWRENCE K. GINSBERG

APNOLD FLEISCHMANN

MARK B. SANDGROUND®

HOWARD C. WEINSTEIN

DAVID A. KUNTZ

JACOB L. CARDIN

OF COUNSEL

June 11, 1979

Mr. Nicholas B. Commodari Chairman - Zoning Plans Advisory Committee County Office Building 111 W. Chesapeake Avenue Towson, Maryland 21204

> RE: Xtra Corporation ( 1-1 Co., INC. & GRANGKE PROPERTIES) 4035 Old North Point Road

#194 Dear Mr. Commodari:


Petitions were filed on March 8th in regard to the above entitled case, and as of this date, we do not have the hearing set. I would appreciate the cases being set in for hearing immediately.

Thanking you for your immediate attention and anticipated cooperation in this matter, I am,

Lawrence K. Ginsberg

Very truly yours,

LKG/hc

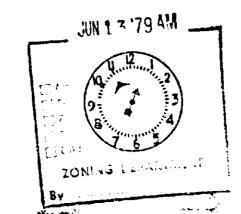

LAW OFFICES CARDIN and WEINSTEIN, P. A.

6615 REISTERSTOWN ROAD SUITE 301 BALTIMORE, MARYLAND 21215 (301) 358-7411

TOWSON, MD. OFFICE 40 W. CHESAPEARE AVE. SUITE 500 TOWSON, MD. 21204 (301) 337-7603

WASHINGTON, D. C. OFFICE 1025 CONNECTICUT AVE. N. W. SUITE 911 WASHINGTON, D.C. 20036 (202) 466-8010

JEROME S. CARDIN WILLIAM I. WEINSTEIN LAWRENCE K. GINSBERG HOWARD C. WEINSTEIN DAVID A. KUNTT ARNOLD FLEISCHMANN MARK B SANDGRUUND

JACOB L. CARDIN

-----

DECEMBER 4, 1980

COUNTY BOARD OF APPEALS ROOM 219 COURT HOUSE TOWSON, MARYLAND 21204

'RE: CASE NO. 80-9-X SOUTHWEST SIDE OF NORTH POINT ROAD X-L CD., INC. GRANOKE PROPERTIES

GENTLEMEN:

PLEASE EXCUSE MY DELAY IN GETTING BACK TO YOU REGARDING THE ABOVE CAPTIONED CASE, BUT I HAVE HAD DIFFICULTY CONTACTING MY CLIENT IN BOSTON.

THE PURPOSE OF THIS LETTER IS TO ADVISE YOU OF THE LANGUAGE TO BE INCORPORATED IN YOUR DRDER IN THE ABOVE CAPTIONED CASE.

THE PETITIONERS HAVE APPEALED THE ZONING COMMISSIONER'S ORDER AND, SPECIFICALLY, PARAGRAPHS 4 AND 6 APPEARING ON THE LAST PAGE OF HIS ORDER, DATED FEBRUARY 6, 1980. THE LANGUAGE OF PARAGRAPH 4 SHOULD BE CHANGED AND INCORPORATED IN THE BOARD'S DRDER

THAT THERE WILL BE ESTABLISHED A 25 FOOT SETBACK FROM THE PROPERTY LINE ALONG NORTH POINT ROAD, WHEREIN NO STACKING OF CONTAINERS SHALL OCCUR.

THAT THERE WILL BE ESTABLISHED A 30 FOOT SETBACK FROM THE PROPERTY LINE ALONG THE SOUTH SIDE OF THE PROPERTY, WHEREIN NO STACKING OF CONTAINERS

THAT THERE WILL BE ESTABLISHED A 20 FOOT SETBACK FROM THE PROPERTY LINE ON THE REMAINING PERIMETER WHEREIN STACKING OF CONTAINERS SHALL BE ALLOWED TO A HEIGHT OF 17 FEET.

IN ALL OTHER AREAS, STACKING OF CONTAINERS SHALL BE ALLOWED TO A HEIGHT OF

THE LANGUAGE OF PARAGRAPH 6 SHOULD BE CHANGED TO READ THAT THE PICKUP AND DELIVERY OF CONTAINERS, CHASSIS, AND TRAILERS, SHALL OCCUR BETWEEN THE HOURS OF 8:00 A.M. AND 6:00 P.M.

BOARD OPEDUCATION O OF BALTIMORE COUNTY

TOWSON, MARYLAND - 21204

Date: March 19, 1979

Mr. S. Eric DiNenna Zoning Commissioner

Z.A.C. Meeting of: March 20, 1979

RE: Item No: 187, 188, 189, 190, 191, 192, 193, 194 Property Owner: Location: Present Zoning: Proposed Zoning:

Baltimore County Office Building

Towson, Maryland 21204

Distric+: No. Acres:

Dear Mr. DiNenna:

All of the above have no bearing on student population,

Very truly yours,

W. Nick Petrovich, Field Representative

MNF/Lp

T. EAYARO WILLIAMS, JR., VICE-PRESIDENT MARCUS M. BOTSARIS

THOMAS H. BOYER MRS. LORRAINE F. CHIRCUS

MRS, MILTON R. SMITH, JR. RICHARD W. TRACEY. D.V.M.

ALVIN LORECK

ROBERT Y. DUSEL, SUPERINTENDENT

WILLIAM E. HAMMOND ZONING COMMISSIONLA

February 6, 1980

Lawrence K. Ginsberg, Esquire 6615 Reisterstown Road Baltimore, Maryland 21215

> RE: Petitions for Special Exceptions SW/S of Old North Point Road. opposite Beachwood and Fischer Roads - 15th Election District X-L Company, Inc. and Granoke Properties - Petitioners NO. 80-9-X (Item No. 194)

Dear Mr. Ginsberg:

I have this date passed my Order in the above referenced latter in accordance with the attached.

> Very truly yours, WILLIAM E. HAMMOND

Zoning Commissioner

WEH/srl

Attachments

cc: Mrs. Marjorie Hill, President Wells McComas Citizens Improvement Association, Inc. 8109 Raymond Avenue Baltimore, Maryland 21222

John W. Hessian, III, Esquire People's Counsel

Cardin and Weinstein, P.A. ATTORNE S AT LAW SUITE 301 6615 REISTERSTOWN ROAD

BALTIMORE, MARYLAND 21215

JEROME S. CARDIN WILLIAM I. WEINSTEIN LAWRENCE K. GINSBERG HOWARD C. WEINSTEIN

JACOB L. CARD'N OF COUNSEL (301) 358-7411

March 6, 1980

Ms. Mary Campagna Baltimore County Office of Planning and Zoning 111 West Chesapeake Avenue Towson, Maryland 21204

RE: Petitions for Special Exceptions SW/S of Old North Point Road opposite Beachwood and Fischer Roads - 15th Election District X-L Company, Inc. and Granoke Properties - Petitioners NO. 80-9-X (Item No. 194)

Dear Ms. Campagna:


Enclosed herewith please find Order for Appeal and a check for \$70 to cover the cost of appealing for the above captioned

Thanking you for your immediate attention herewith, I am,

Lawrence K. Ginsberg

Very truly yours,

LKG/hc encl.

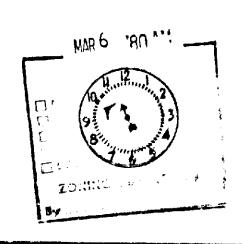

JOHN W. HESSIAN, III

People's Counsel

PETER MAX SIMMERMAN

Deputy People's Counsel

Baltimore County, Maryland

PEOPLE'S COUNSEL RM. 223, COURT HOUSE TOWSON, MARYLAND 21204

TEL. 494-2188

December 18, 1980

Lawrence K. Ginsberg, Esquire Cardin and Weinstein, P. A. 6615 Reisterstown Road, Suite 301 Baltimore, Maryland 21215

> RE: Case No. 80-9-X - SW/S North Point Rd. 12th Election District - X-L Company, Inc. and Granoke Properties, Petitioners


Dear Mr. Ginsberg:

Enclosed is a copy of the memorandum of James E. Dyer, Zoning Supervisor, pertinent to restrictions on the above-entitled case. A copy has been transmitted to the County Board of Appeals.

Very truly yours,

May Lumer Peter Max Zimmerman Deputy People's Counsel

cc: John V. Murphy, County Board of Appeals William E. Hammond, Zoning Commissioner James E. Dyer, Zoning Supervisor

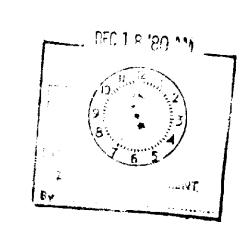

Sten 10. 194

JOHN G. NOPPINGER ATTORNEY AT LAW 1101-2 FIDELITY BUILDING BALTIMORE, MD. 21201

539-3816

HOME: 825-9386

May 24, 1979

Mr. William E. Hammond Zoning Commissioner 111 W. Chesapeake Avenue Towson, Maryland 21204

> Re: Old North Point Road property Xtra Corporation

Dear Mr. Hammond:

Xtra Corporation, through Stevens & Associates, has applied for an extension of its special exception for a truck parking facility on unimproved land along Old North Point Road in the 15th District of Baltimore Councy. The application was filed early this year and all parties are interested in having this matter decided as quickly as possible. In your office Mr. Commaderi has all the information pertaining to this property.

Xtra Corporation is a contract purchaser of an additional two acres and I am one of the owners. The contract exitres on June 30, 1979 and whatever you can do to expedite this matter will be greatly appreciated.

Very truly yours,

JGN: & ∂a

P.S. Congratulations upon your appointment as Zoning Commissioner for Baltimore County.

BALTIMORE COUNTY, MARYLAND

INTER-OFFICE CORRESPONDENCE

William E. Hammond TO\_Zoning Commissioner

July 2, 1979 Norman E. Gerber, Acting Director FROM Office of Planning and Zoning

SUBJECT Petition 80-9X. Item 194 Petition for Special Exceptions

Southwest side of Old North Point Road, opposite Beachwood Road and Fischer Road Petitioner - X-L Co., Inc. and Granoke Properties

15th District

HEARING: Wednesday, July 11, 1979 (1:15 P.M.)

This office offers no comment on the subject petition other than to note that if granted, the plan must be approved in conformance with the applicable provisions of County Council Bill No. 18-76 governing trucking facilities.

Office of Planning and Zoning

NEG:JGH:rw

Lawrence K. Ginsberg, Esquire 6615 Relsterstown Road Baltimore, Maryland 21215

NOTICE OF HEARING

RE: Petition for Special Exceptions, SW/S Old North Point Rd., opposite Beachwood Road and Fischer Rd. - 15th District, X-L Co., Inc. and Granoke Properties - Petitioners, Case No. 80-9-X

TIME: 1:15 P.M. Wednesday, July 11, 1979

PLACE: ROOM 106 COUNTY OFFICE BUILDING, 111 W. CHESAPEAKE AVENUE,

TOWSON, MARYLAND

BALTIMORE COUNTY
OFFICE OF PLANNING & ZONING
TOWSON, MARYLAND 21204
494-3353

CHOMBAR 3 MACON

ZONNA COMMUNICAÇÃ

June 29, 1979

BALTIMORE COUNTY, MARYLAND

INTER-OFFICE CORRESPONDENCE

SUBJECT X-L Company, Inc. - SW/S of North Point Road - 12th Election District (Case No. 80-9-X)

and/or special hearing, should include the following restrictions with regard to

repair of chassis and/or containers on the subject property. The restrictions

It is my opinion that any Order granting the requested special exception

of chassis and trailers shall take place on the subject property.

Such maintenance and repairs are intended to include changing

tires, greasing chassis, repair of container hinges, doors,

Only repairs of a minor nature and general maintenance

Date December 10, 1980

Peter M. Zimmerman, Esquire

TO\_Deputy Counsel

Mr. James E. Dyer

FROM Zoning Supervisor

latches, etc.

cc: Mr. William E. Hammond

.Zoning Commissioner

shall be as follows:

JED/sf

Lawrence K. Gineberg, Esquire 6615 Peisterstown Road Paltimore, Haryland 21215

> PE: Petitionfor Special Exceptions, SW/S Old North Point Rd., oppostie Beachwood Road and Fischer Road - 15th Metrict, X-L Co., Inc. and Granoke Properties - Petitioners, Case No. 80-9-X

Dear Sir:

This is to advise you that \$63.22 advertising and posting of the above property.

Please make check payable to Ealtimore County, Maryland and remit to Mrs. Jones, Room 113, County Office Building, Towson, Maryland 21204, before the hearing.

Very truly yours,

A December 1

William E. Hammond Zoning Commissioner

WEE/sj

March 7, 1980

Lawrence K. Ginsberg, Esquire Cardin and Weinstein, P.A. Suite 301 6615 Reisterstown Road Baltimore, Maryland 21215

> RE: Petition for Special Exception SW/S Old North Point Road opp. Beachwood and Fischer Roads X-L Company, Inc. and Granoke Properties Case No. 80-9-X

Dear Mr. Ginsberg:

Regarding the Appeal filed with this office on Thursday, March 6, 1980. please be advised that an additional \$5.00 is due for posting of said property.

Very truly yours.

WILLIAM E. HAMMOND Zoning Commissioner

WEH: s.j

Mr. James E. Dyer

March 27, 1981

Page 2

acceptable, please advise us as soon as possible so that we may determine our course of action. Obviously, my concern is that if we have to obtain approval on the overall tract merely to facilitate the proposed addition on the 3 acre tract this will lead to protracted discussions, comments, etc. prior to approval.

Thank you for your consideration in this matter.

very truly yours,

GEORGE WILLIAM STEPHENS, JR. AND ASSOCIATES, INC.

Charles E. Fick

CEF/ctp Enclosures CC: Mr. Vincent Citarella PETITION FOR SPECIAL EXCEPTIONS

15th District

ZONII. Petition for Special Exceptions

LOCATION: Southwest side of Old North Point Road, opposite Beachwood Road and Fischer Road

DATE & TIME: Wednesday, July 11, 1979 at 1:15 P.M.

PUBLIC HEARING: Room 106, County Office Building, 111 W. Chesapeake Avenue, Towson, Maryland

The Zoning Commissioner of Baltimore County, by authority of the Zoning Act and Regulations of Baltimore County, will hold a public hearing:

> Petitions for Special Exceptions for an amendment to existing truck terminal site plan to allow expansion of site area and for an amendment to approved site plan to allow an a ldition to the existing office building for the existing truck terminal

All that parcel of land in the Fifteenth District of Baltimore County

Being the property of X-L Co., Inc. and Granoke Properties, as shown on plat plan filed with the Zoning Department

Hearing Date: Wednesday, July 11, 1979 at 1:15 P.M. Public Hearing: Room 106, County Office Building, 111 W. Chesapeake Avenue, Towson, Maryland

BY ORDER OF WILLIAM E. HAMMOND ZONING COMMISSIONER OF BALTIMORE COUNTY March 13, 1980

Mrs. Marjorie Hill, President Wells McComas Citizens Improvement Assn., Inc. 8109 Raymond Avenus Baltimore, Maryland 21222

> RE: Petitions for Special Exception SW/S Old North Point Road. opposite Beachwood and Fischer X-L Company, Inc. and Granoke Properties Саве Но. 80-9-X

Dear Mrs. Hill:

Please be advised that an Appeal has been filed by Lawrence K. Ginsberg, Esquire on tehalf of the Petitioners, from the decision rendered by the Zoning Commissioner of Baltimore County in the abovereferenced matter.

You will be notified of the date and time of the appeal hearing when it is scheduled by the County Board of Appeals.

Very truly yours,

WILLIAM E. HAMMOHD Zoning Commissioner

WEE:ej

cc: John W. Hessian, III, Esquire

GEORGE WILLIAM STEPHENS. AND ASSOCIATES, INC. CONSULTING ENGINEERS GEORGE WILLIAM STEPHENS II CHAIRMAN OF THE BOARD W HARRY JESSOP IR 1 S CHARLES E FICK P.E. FRANCIS W. ZEIGLER JR. L.S. JOHN L STAMM P.F. March 27, 1981 WHITEAM R SUDECK PE J. STRONG SMITH PE

Zoning Commissioner's Office Baltimore County Office Building Towson, Maryland 21204

PETITION FOR SPECIAL EXCEPTIONS—15th DISTRICT

ZONING: Petition for Special Ex-

ceptions
LOCATION: Southwest side of Old

North Point Road, opposite Beachwood Road and Fischer

Road
DATE & TIME: Wednesday, July
11, 1979 at 1:15 P.M.
PUBLIC HEARING: Room 198,
County Office Building, 111 W.
Chesapeake Avenue, Towaon,
Maryland.

The Zoning Commissioner of Bal-

timore County, by authority of the Zoning Act and Regulations of Bai-

hearing:
Petitions for Special Exceptions

Fetitions for Special Exceptions for an amendment to existing truck terminal site blan to allow expansion of site area and for an amendment to sporoved site plan to allow an addition to the existing office building for the existing truck terminal

All that parcel of land in the Fif-teenth District of Baltimore Coun-

Beginning for the same at the end

of the two following courses vis: first, commencing at a point on the southwest side of Old North Point

Road 40 feet wide, said point being the southeast side of Battle Grove Road 40 feet wide and running thence along the southwest side of Old North Point Yoad southeasterly 446 feet more or less and second, leaving said road South 66° 09' 41' West 285 feet more or less to said place of beginning Engine House

place of beginning, running thence the two following courses viz: (1) South 47" 33" 56" East 614.13 feet and

South 47' 39' 56" East 614.13 feet and (2) North 50° 57' 20' East 188.22 feet to the southwest side of Old North Point Road, thence binding thereon (3) 8 with 35° 02' 40' East 187.25 feet, thence les ving said road the three following courses vis: (4) South 50° 57' 30'' West 150.00 feet and (6) North 54° 21' 23" Last 148.48 feet to the southwest side of said Old North Point Road, thence binding thereon (7) southeasterly by a

of some Point Road, thence binding thereon (7) southeasterly by a curve to the right having a radius of 839.04 feet and a distance of 439.22 feet, thence leaving said road and running the feur following courses vis: (8) South 66° 22' 40° West 118.80 feet (4) North 200

Courses vis: (8) So th 66° 22' 40° West 118.80 feet, (9) North 47° 44' 10° West 543.58 feet, (10) North 47° 33' 56° West 653.26 feet and (11) North 86° 08' 41° East 150.21 feet to

more or less.
The herein above described \$.000

The herein above described \$.000 sere parcel being a part of that \$ acre tract of land having been granted a special exception for a truck terminal in Case No. 66-96-X. Being the property of X-L Co., Inc., and Granoke Properties, as shown on right plan filed with the Zoning Department

Prown on that plan filed with the Zoning Department
Hearing Date: Wednesday, July
11, 1979 at 1:15 P.M.
Public Hearing: Room 108, County Office Building, 111 W. Cheen-peake Avenue, Towson, Maryland.
By Order Of
WILLIAM E. HAMMOND,
Zoning Commissioner

Zoning Commissioner of Baltimore County June 21.

Attention: Mr. James E. Dyer, Zoning Supervisor

X-L COMPONY, INC. and GRANORS PROPERTY RE: Case No. 80-9-X XL Company, Inc.

220 S. MAIN ST

BEL AIR MD 21014

879-1500

Dear Jim:

TAPOBRATA CHAKRAHARELPE

CHAPIFSK STARK 1 S

ROBERT B BARKELL

Re: Proposed Brilding Addition (X-L CO., INC.)

Approximately 2 weeks ago we submitted a revised site plan for the original three acre truck terminal showing those conditions as they exist on the site today as well as the restrictions imposed by the Zoniny Commissioner and further modified by the board of Appeals Order. Inasmuch as there seems to be some difficulty in your office obtaining a copy of the plat that is referred to in the Board of Appeals Order, I am enclosing a corm of said plat as it was marked up for the Board of Appeals hearing. I am also enclosing a copy of the Board of Appeals opinion. As you probably know, the subject of the petition originally was simply the 2 acre expansion of the present truck terminal. Unfortunately, the Zoning Commissioner not only addressed that 2 acre portion but went back to the then existing truck terminal site and imposed additional restrictions on that already existing operation. All these issues have been resolved with the Board of Appeals opinion and, therefore, what we are really deing in effect is merely updating the original three acre parcel to reflect those conditions and at the same time request the approval for the proposed building addition shown thereon. We are not at the present time interested in pursuing the 2 acre expansion area but are quite anxious to pursue the building addition for the 3 acre original parcel. On that basis, we are requesting that this modification of the original 3 acre site plan be treated independently and reviewed and approved as a separate entity. I do not believe that it was the intent of the order or orders to necessarily require that the total site come back in for approval all at one time.

I would appreciate if you would consider this request and process the three acre site plan revision at your earliest possible convenience. If this is not

### CERTIFICATE OF POSTING ZONING DEPARTMENT OF BALTIMORE COUNTY Towson, Maryland

K WY V

District 15	Date of Posting 3/15/90
Remarks:	
	Date of return: 24/2014
1 12 5gm	

### CERTIFICATE OF POSTING ZONING DEPARTMENT OF BALTIMORE COUNTY Towson, Maryland

District 15th Date of Posting June 29, 1979
Posted for: X-L Company Inc. & Granake Properties
Petitioner: X-L Company
Petitioner: X-L Company  Location of property: 5/w/5 of Old North Point Road, opposite  Beachwork Road & Fischer Road
Beachwood Road & Fischer Road
Location of Signs: Front of Property near-during entrance
Remarks: Myns attached to fince
Remarks: Myns attached to fince  Posted by Gary C-Freud Date of return: June 29, 1979  Signature

OFFICE OF SPECIAL EXCEPTIONS
15th District
ZONING: Petition for Special Exceptions
LOCATION: Southwest sine of
Old North Point Road, opposite Beachwood Road and Fischer Road DATE & TIME: Wednesday, July 11, 1979 at 1:15 P M PUBLIC HEARING: Room 106. 19 79 TOWSON, MD. 21204 County Office Building, 111 W Chesapeake Avenue, Towarin, Maryland The Zoning Commissioner of Baltimore County, by authority of the Zoning Act and Regulations of June 20 Sattimore County, will hold a pub lic hearing: Patitions for Special Exceptions THIS IS TO CERTIFY, that the annexed advertisement of PETITION FOR SPECIAL EXCEPTIONS - X-L Co., Inc., for an amendment to existing truc terminal site plan to allow ex-pansion of site area and for ar & Granoke Properties was inserted in the following: amendment to approved one pia to allow an addition to the exating office building for the existing truc terminal
All that parcel of land in the County

Beginning for the same at the end of the two following courses ☐ Arbutus Times ☐ Catonsville Times Essex Times ☐ Community Times wz first, commencing at a point on the southwest side of Old North Point Road 40 feet wide said point being the southeast side of Sattle Grove Road 40 feet wide and run-☐ Towson Times southeasterly 446 feet more or less and senond, leaving said road South 66° 09' 41" West 269 feet more or less to said place of beginweekly newspapers published in Baltimore, County, Maryland, ning, running thence the two fol fowing courses viz: (1) South 47° 36 56" East 614.13 feet and (2) once a week for \_\_\_\_\_\_ successive weeks before the North 50" 57" 20" East 188 22 fee 22nd day of June 1979, that is to say, the same to the southwest side of Old North Point Road, thence binding there-on (3) South 39" 02" 40" East 93.75 was inserted in the issues of June 21, 1979 feet, thence leaving said road the three following courses viz: (4) South 50" 57" 20" West 150 00 feet, (5) South 38° 02' 40" East 50 00 feet and (6) North 54° 21' 33" East 148 48 feet to the southwest side of said Old North Point Road Manor STROMBERG PUBLICATIONS, INC. by a curve to the right having a radius of 939.04 feet and a dis-tance of 439.22 test, thence leaving said road and running the four following courses viz. (8) South 66" 22" 40" West 118.80 fest, (9) North 47" 44" 10" West 543.58 fest, (10) North 47" 39" 56" West 653.98 fest and (11) North 66° 09' 41" East 150 21 feet to the place of begin-Containing 5 000 acres of land more or less.

The herein above described 5 000 acre parcel being a part of that 8 acre tract of land having been granted a special exception for a truck terminal in Case No. 64-04.17 15 District

**∮80-**9 ∷ (Itom \* . . 4)

86-96-X.
Being the property of X-L Co., Inc. and Granoke Properties, as shown on plat plan hied with the Zoning Department.
Hearing Date Wednesday, July 11, 1979 at 1:15 P.M.
Public Hearing: Roosn 106, County Office Building, 111 W. Chesapeake Avenue, Towson, Maryland.

WILLIAM E HAMMON ZONING COMMISSIONER OF BALTIMORE COUNTY SW/S Old North Polist Rd.,

opposite Beautweed & Fischer Rds. X-L Company, Inc. and Granoka Properties

1 SIGN

CERTIFICATE OF PUBLICATION

TOWSON, MD. 19-79 THIS IS TO CERTIFY, that the annexed adverdsement was published in THE JEFFERSONIAN, a weekly newspaper printed and published in Towson, Baltimore County, Md., onoccinceache ofx one time successive excessive excessive before the lith day of \_\_\_\_\_\_\_\_, 19.72, the KM publication appearing on the 21st day of June 19.79...

Cost of Advertisement, \$\_\_\_\_

the place of beginning.

Containing 5.000 acres of land, \*\*Commenced to the commenced of th BALTIMORE COUNTY, MARYLAND Mo. 86327 OFFICE OF FINANCE - REVENUE DIVISION MISCELLAMEOUS CASH RECEIPT

DATE March 7. 1980 ACCOUNT 01-662

AMOUNT \$70.00

FROM: Lawrence K. Ginsberg, Esquire Filling Fee for Appeal of Case No. 80-9-X

VALIDATION OR SIGN TURE OF CASHIER

10 4 5 At 15 7

BALTIMORE COUNTY, MARYLAND OFFICE OF FINANCE - REVENUE DIVISION MISCELLANEOUS CASH RECEIPT	No. 86345
DATE Morch 19, 1980 Acco	unt01=662
AMO	unt_\$5.00
RECEIVED Cardin & Weinstein	
FOR: Posting fee for Appeal	
&4 9 SAMA 20	5.0 Cm2
VALIDATION OR SIG	GNATURE OF CASHIER
BALTIMORE CCUNTY, MARYLAND OFFICE OF FINANCE REVENUE DIVISION MISCELLANEOUS CASH RECEIPT	No. 78779
DATE July 10, 1979 ACCOUNT	01-662
•	NT\$69.22
RECEIVED X-L Co., Inc., Vince	nt M. Citorella
RECEIVED X-L Co., Inc., Vince: FOR: Porting and Advertising f  VALIDATION OR SIGN  BALTIMORE COUNTY, MARYI AND OFFICE OF FINESCE REVENUE DIVISIO	nt M. Citorella or Case #80-9-X  11 6922 30  No. 78724
BALTIMORE COUNTY, MARYI AND OFFICE OF FINANCE REVENUE DIVISION MISCELLANE CASH RECEIPT	nt M. Citorella or Case #80-9-X  11 69.22 30  No. 78724
BALTIMORE COUNTY, MARYI AND OFFICE OF FINE CASH RECEIPT  June 14, 1979  ACCO	nt M. Citorella or Case #80-9-X  11 69.22 36  NATURE OF CASHIER  NO. 78724  UNT 01-662
BALTIMORE COUNTY, MARYI AND OFFICE OF FINE CE REVENUE DIVISIO MISCELLANE CASH RECEIPT  June 14, 1979  ACCO	nt M. Citorella or Case #80-9-X  11 69.22 30  No. 78724  No. 78724  UNT 01-662  UNT \$50.00
BALTIMORE COUNTY, MARYI AND OFFICE OF FINANCE REVENUE DIVISION MISCELLANE CASH RECEIPT  June 14, 1979  AMO  RECEIVED Cardin & Weinstein	nt M. Citorella or Case #80-9-X  11 69.22 30  No. 78724  No. 78724  UNT 01-662  UNT \$50.00



BALTIMORE COUNTY OFFICE OF PLANNING AND ZONING

County Office Building 111 W. Chesapeake Avenue Towson, Maryland 21204

> \_\_\_Cash \_\_\_Other

S. Eric DiNenna,
Zoning Commissioner


Petitioner's Attorney L. GINSBERC Reviewed by MA

\* This is not to be interpreted as acceptance of the Petition for assignment of a hearing date.








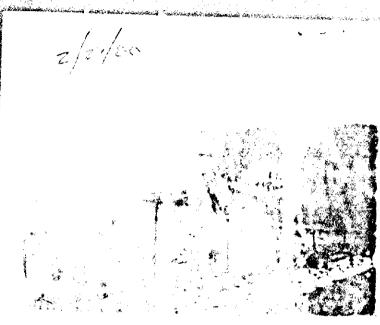







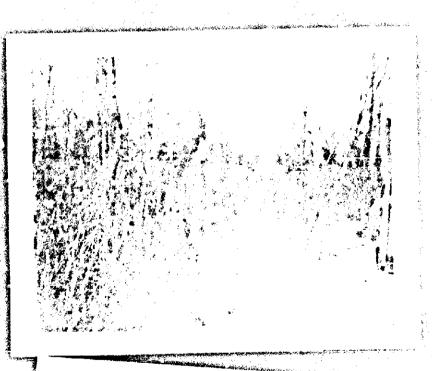




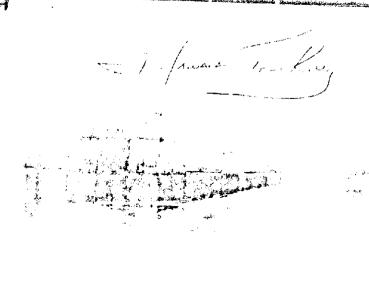



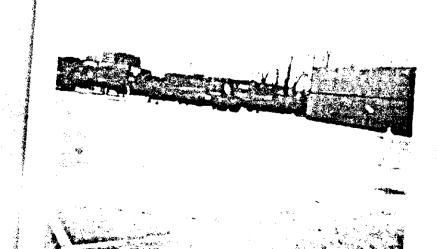

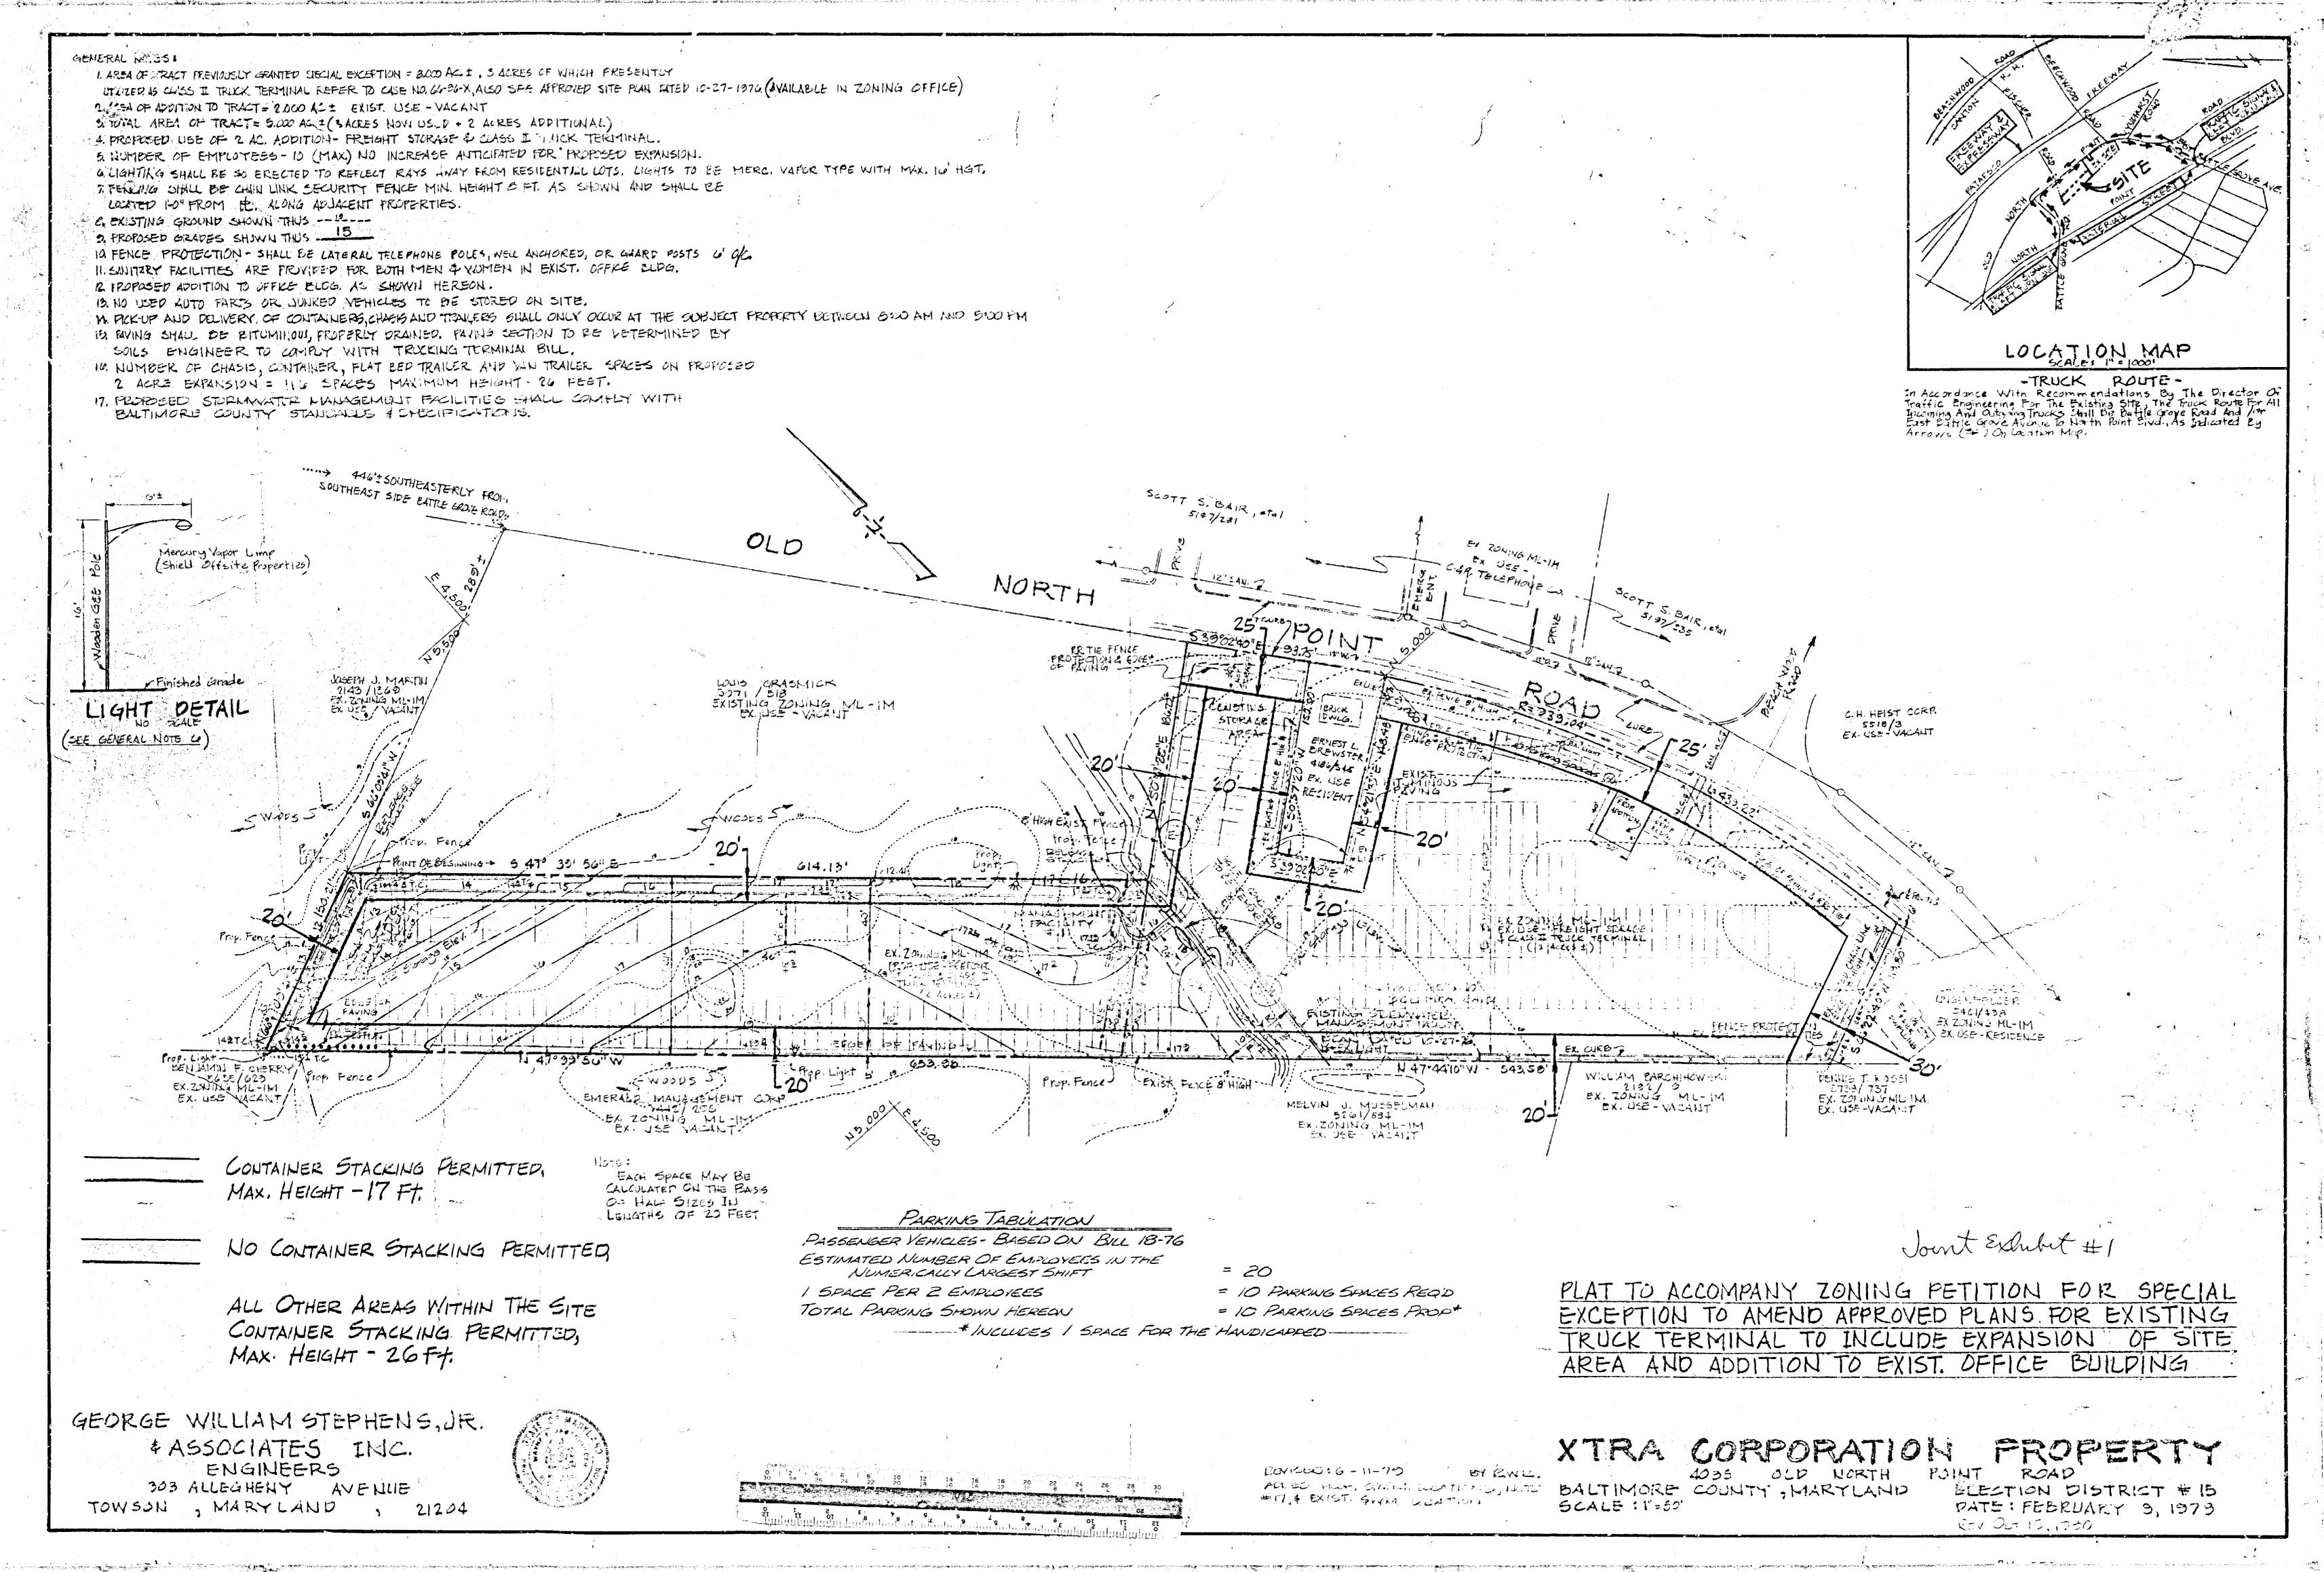

## PETITION FOR ZONING RE-CLASSIFICATION AND/OR SPECIAL EXCEPTION

TO THE ZONING COMMISSIONER OF BALTIMORE COUNTY:

I, or we, Granoke Properties legal owner of the property situate in Baltimore County and which is described in the description and plat attached hereto and made a pro- hereof, hereby petition (INIDAIXODEXIONINK statosxod/ibecterativalescribed/respectively) -ixiv kaususut XIOCITEXCECURITE ADMICIOCARRILLINGUESCECURITA XIOCUTO CONTEXE CONTEXE AND ANALYZO CONTEXE CONT 

and (2) for a Special Exception, under the said Zoning Law and Zoning Regulations of Baltimore County, to use the herein described property, for Amendment to existing truck terminal site plan to allow expansion of site area.

55

Property is to be posted and advertised as prescribed by Zoning Regulations.

I, or we, agree to pay expenses of above re-classification and/or Special Exception advertising, posting, etc., upon filing of this petition, and further agree to and are to be bound by the zoning regulations and restrictions of Baltimore County adopted pursuant to the Zoning Law for Baltimore County.

Granoke Properties Jegal Owner
John G. Noppinger, General Partner
Address 1101 Fidelity B lding Contract purchaser Address 60 State Street Boston, Mass. 02109 Baltimore, Maryland 21201 Protestant's Attorney Lawrence K. Ginsbergetitioner's Attorney CARDIN and WEINSTEIN, P.A. Address \_ 6615 Reisterstown Road Baltimore, Maryland 21215


ORDERED By The Zoning Commissioner of Baltimore County, this\_\_\_\_day of\_\_\_June\_\_\_\_, 197 2, that the subject matter of this petition be advertised, as required by the Zoning Law of Baltimore County, in two newspapers of general circulation throughout Baltimore County, that property be posted, and that the public hearing be had before the Zoning Commissioner of Baltimore County in Room 106, County Office Building in Towson, Baltimore County, on the \_\_\_\_\_o'clock P.\_M. Zoning Commissioner of Baltimore County.

0

RE: PETITIONS FOR SPECIAL EXCEPTIONS BEFORE SW/S of Cld North Point Road, opposite COUNTY BOARD OF APPEALS Beachwood and Fischer Roads 15th District X-L Company, Inc. and Granoke **BALTIMORE COUNTY** Properties, Petitioners

OPINION

0

No. 80-9-X

This case comes to the Board from the decision of the Zoning Commissioner's granting a special exception in regard to the development of the subject property as a truck terminal pursuant to Bill 18-76. In a quite lengthy Opinion, the Zoning Commissioner granted the special exception with seven paragraphs of conditions and restrictions. The Petitioners appeal from the Zoning Commissioner's decision in regard to Paragraph 4 and Paragraph 6 of the Zoning Commissioner's decision, and these are the only issues before this Board.

In Paragraph 4 of the Zoning Commissioner's Opinion, the Zoning Commissioner limited the method and height of stacking of containers (ship cargo containers) on the subject property. After lengthy negotiations between the community, with the People's Counsel and the land owners, a compromise position was reached and was submitted to the Bourd through Joint Exhibit 1, indicating a plan for the stacking of containers on the property. This plan limits the height of container stacking in the immediate border area of the property thus satisfying the basic concerns of the community and the People's Counsel. Mr. Charles Fick, consulting engineer, testified as to the fact that the Joint Exhibit 1 would serve as the site plan for the property and that with the compromise reached, now meets all the criteria as set forth in Truck Terminal Legislation for Baltimore County. The Board hereby accepts the site plan and incorporates its provisions into its Order.

# PETITION FOR ZONING RE-CLASSIFICATION AND/OR SPECIAL EXCEPTION

TO THE ZONING COMMISSIONER OF BALTIMORE COUNTY:

I, or we, X-L-CO., INC. legal owner of the property situate in Baltimore County and which is described in the description and plat attached hereto and made a part hereof, hereby petition INVIDEX VINEY COLORS CENTURY OF THE WARRENCE SCALE AND AND COLORS COLO TO CHARLE OF THE CONTROL OF THE CONT 

and (2) for a Special Exception, under the said Zoning Law and Zoning Regulations of Baltimore County, to use the herein described property, for Amendment to approved site plan to allow addition to existing office building for existing truck terminal.

Property is to be posted and advertised as prescribed by Zoning Regulations. I, or we, agree to pay expenses of above re-classification and/or Special Exception advertising. pisting, etc., upon filing of this petition, and further agree to and are to be bound by the zoning ulations and restrictions of Baltimore County adopted pursuant to the Zoning Law for Baltimore

Contract purchaser X-L-CO., INC. Address X-L-CO. INC.
60 State Street Boston, Mass. 02109 awrence K. Ginsberg Petitioner's Attorney Protestant's Attorney CARDIN AND WEINSTEIN, P.A. Address 6615 Reisterstown Road
Baltimore, Maryland 21215 

ORDERED By The Zoning Commissioner of Baltimore County, this\_\_\_\_day of\_\_\_June, 1972, that the subject matter of this petition be advertised, as required by the Zoning Law of Baltimore County, in two newspapers of general circulation throughout Baltimore County, that property be posted, and that the public hearing be had before the Zoning Commissioner of Baltimore County in Room 106, County Office Building in Towson, Baltimore \_\_\_\_\_day of July \_\_\_\_\_, 197 9/, at 1:15 \_₽.\_M.

sioner allowed operations for the subject property between 8 a.m. and 5 p.m.

necessarily extend beyond those times. The Board accepts this position.

Petitioners request, in their December 4, 1980 Memorandum, that the hours should be

changed to read 8 a.m. to 6 p.m., and be limited to pick up and delivery of containers,

chassis and trailers, rather than the entire site operation which includes office hours which

that "only repairs of a minor nature and general maintenance of chassis and trailers shall

include changing tires, greasing chassis, repair of container hinges, doors, latches, etc.

The Board accepts this condition as reasonable and incorporates it into its Opinion.

ORDER

of January, 1981, by the County Board of Appeals, ORDERED that the site plan defining

containers, chassis and trailers shall occur between the hours of 8 a.m. and 6 p.m., and it

including changing tires, greasing chassis, repairing container hinges, doors, latches, etc.,

repairs of a minor nature and general maintenance of containers, chassis and trailers,

the stacking of cargo containers, known as Joint Exhibit 1, he incorporated into the site

The County further suggests, in their December 10, 1980 Memorandum,

For the reasons set forth in the aforegoing Opinion, it is this 29th day

FURTHER ORDERED that the hours of operation for pick up and delivery of

FURTHER ORDERED that the operations at the site be limited in regard to

Such maintenance and repairs are intended to

take place on the subject property.

plan for this property, and it is

and it is

X-L Company, Inc. and Granoke Properties = #80-9-X

Zoning Commissioner of Baltimore County.

In Paragraph 6 of the Zoning Commissioner's Opinion, the Zoning Commis-

WEPSTEIN P.A.

ATTERNITY AT LAW 59018-364 5 PERTIASTOWN FOAD LT (URE, MD 21215 THORE (301) 356-7411

2000

RE: Petitions for Special Exceptions \* BEFORE THE ZONING COMMISSIONER

SW/S of Old North Point Road, opposite Beachwood and Fischer \* OF BALTIMORE COUNTY Roads, 15th Election District X-L Company, Inc. and Granoke Properties - Petitioners NO. 80-9-X (Item No. 194)

ORDER FOR APPEAL

Dear Mr. Commissioner:

Please note an appeal from your decision in the above-entitled matter, under date of February 6, 1980, to the County Board of Appeals and forward all papers in connection therewith to said Board for hearing.

> Lawrence K. Ginsberg 6615 Reisterstown Road, Ste. 301 Baltimore, Maryland 21215

CARDIN AND WEINSTEIN, P.A.

(301) 558-7411 Attorney for the Petitioners: X-L COMPANY, INC. 60 State Street Foston, Massachusetts 02109 GRANORE PROPERTIES

Attention: John G. Noppinger 1101 Fidelity Building Baltimore, Maryland 21201

MAR 6 '80' 14 20 Down a mark with well

X-L Company, Inc. and Granoke Properties - #80-9-X

FURTHER ORDERED that these modifications shall take effect within ten (10) days from the date of this Order.

Any appeal from this decision must be in accordance with Rules B-1 thru

COUNTY BOARD OF APPEALS OF BALTIMORE COUNTY

B-12 of the Maryland Rules of Procedure.

494-3180

County Board of Appeals Room 219, Court House Towson, Maryland 21204

April 28, 1980 NOTICE OF ASSIGNMENT

NO POSTPONEMENTS WILL BE GRANTED WITHOUT GOOD AND SUFFICIENT REASONS. REQUESTS FOR POSTION MENTS MUST BE IN WRITING AND IN STRICT COMPLIANCE WITH BOARD RULE 2(b). ABSOLUTELY NO POSTPONE-MENTS WILL BE GRANTED WITHIN FIFTEEN (15) DAYS OF SCHEDULED HEAR-ING DATE IN ACCORDANCE WITH RULE 2(c), COUNTY COUNCIL BILL \$108

CASE NO. 80-9-X

X-L COMPANY, INC. and GRANOKE PROPERTIES

SE-Amendment to existing truck terminal site plan to allow expansion of site area and also to allow addition to existing office building

SW/S of Old North Point Rd., opposite Beachwood and Fischer Rds.

15th District

2/6/80--Z.C. GRANTED Special Exception with restrictions

ASSIGNED FOR:

WEDNESDAY, JUNE 11, 1980, at 10 a.m.

cc: Lawrence K. Ginsberg, Esq. Attorney for Petitioners

X-L Company, Inc. Petitioner

Granoke Properties

Mrs. Marjorie Hill Protestant

John W. Hessian, Esq. U People's Counsel

J. E. Dyer Zoning

W. Hammond

James Hoswell Planning

June Holmen, Secry.

\_\_\_\_\_

RE: Petitions for Special Exceptions \* BEFORE THE ZONING COMMISSIONER SW/S of Old North Point Road,

opposite Beachwood and Fischer \* OF BALTIMORE COUNTY Roads, 15th Election District X-L Company, Inc. and Granoke

Properties - Petitioners NO. 80-9-X (Item No. 194)

ORDER FOR APPEAL

Dear Mr. Commissioner:

Please note an appeal from your decision in the above-entitled matter, under date of February 6, 1980, to the County Board of Appeals and


forward all papers in connection therewith to said Board for hearing. 6615 Reisterstown Road, Ste. 301 Baltimore, Maryland 21215


(301) 558-7411 Attorney for the Petitioners X-L COMPANY, INC. 60 State Street Boston, Massachusetts 02109 GRANOKE PROPERTIES Attention: John G. Noppinger 1101 Fidelity Building Baltimore, Maryland 21201


MAR 6 '80'

WE WITHOUT P.A.


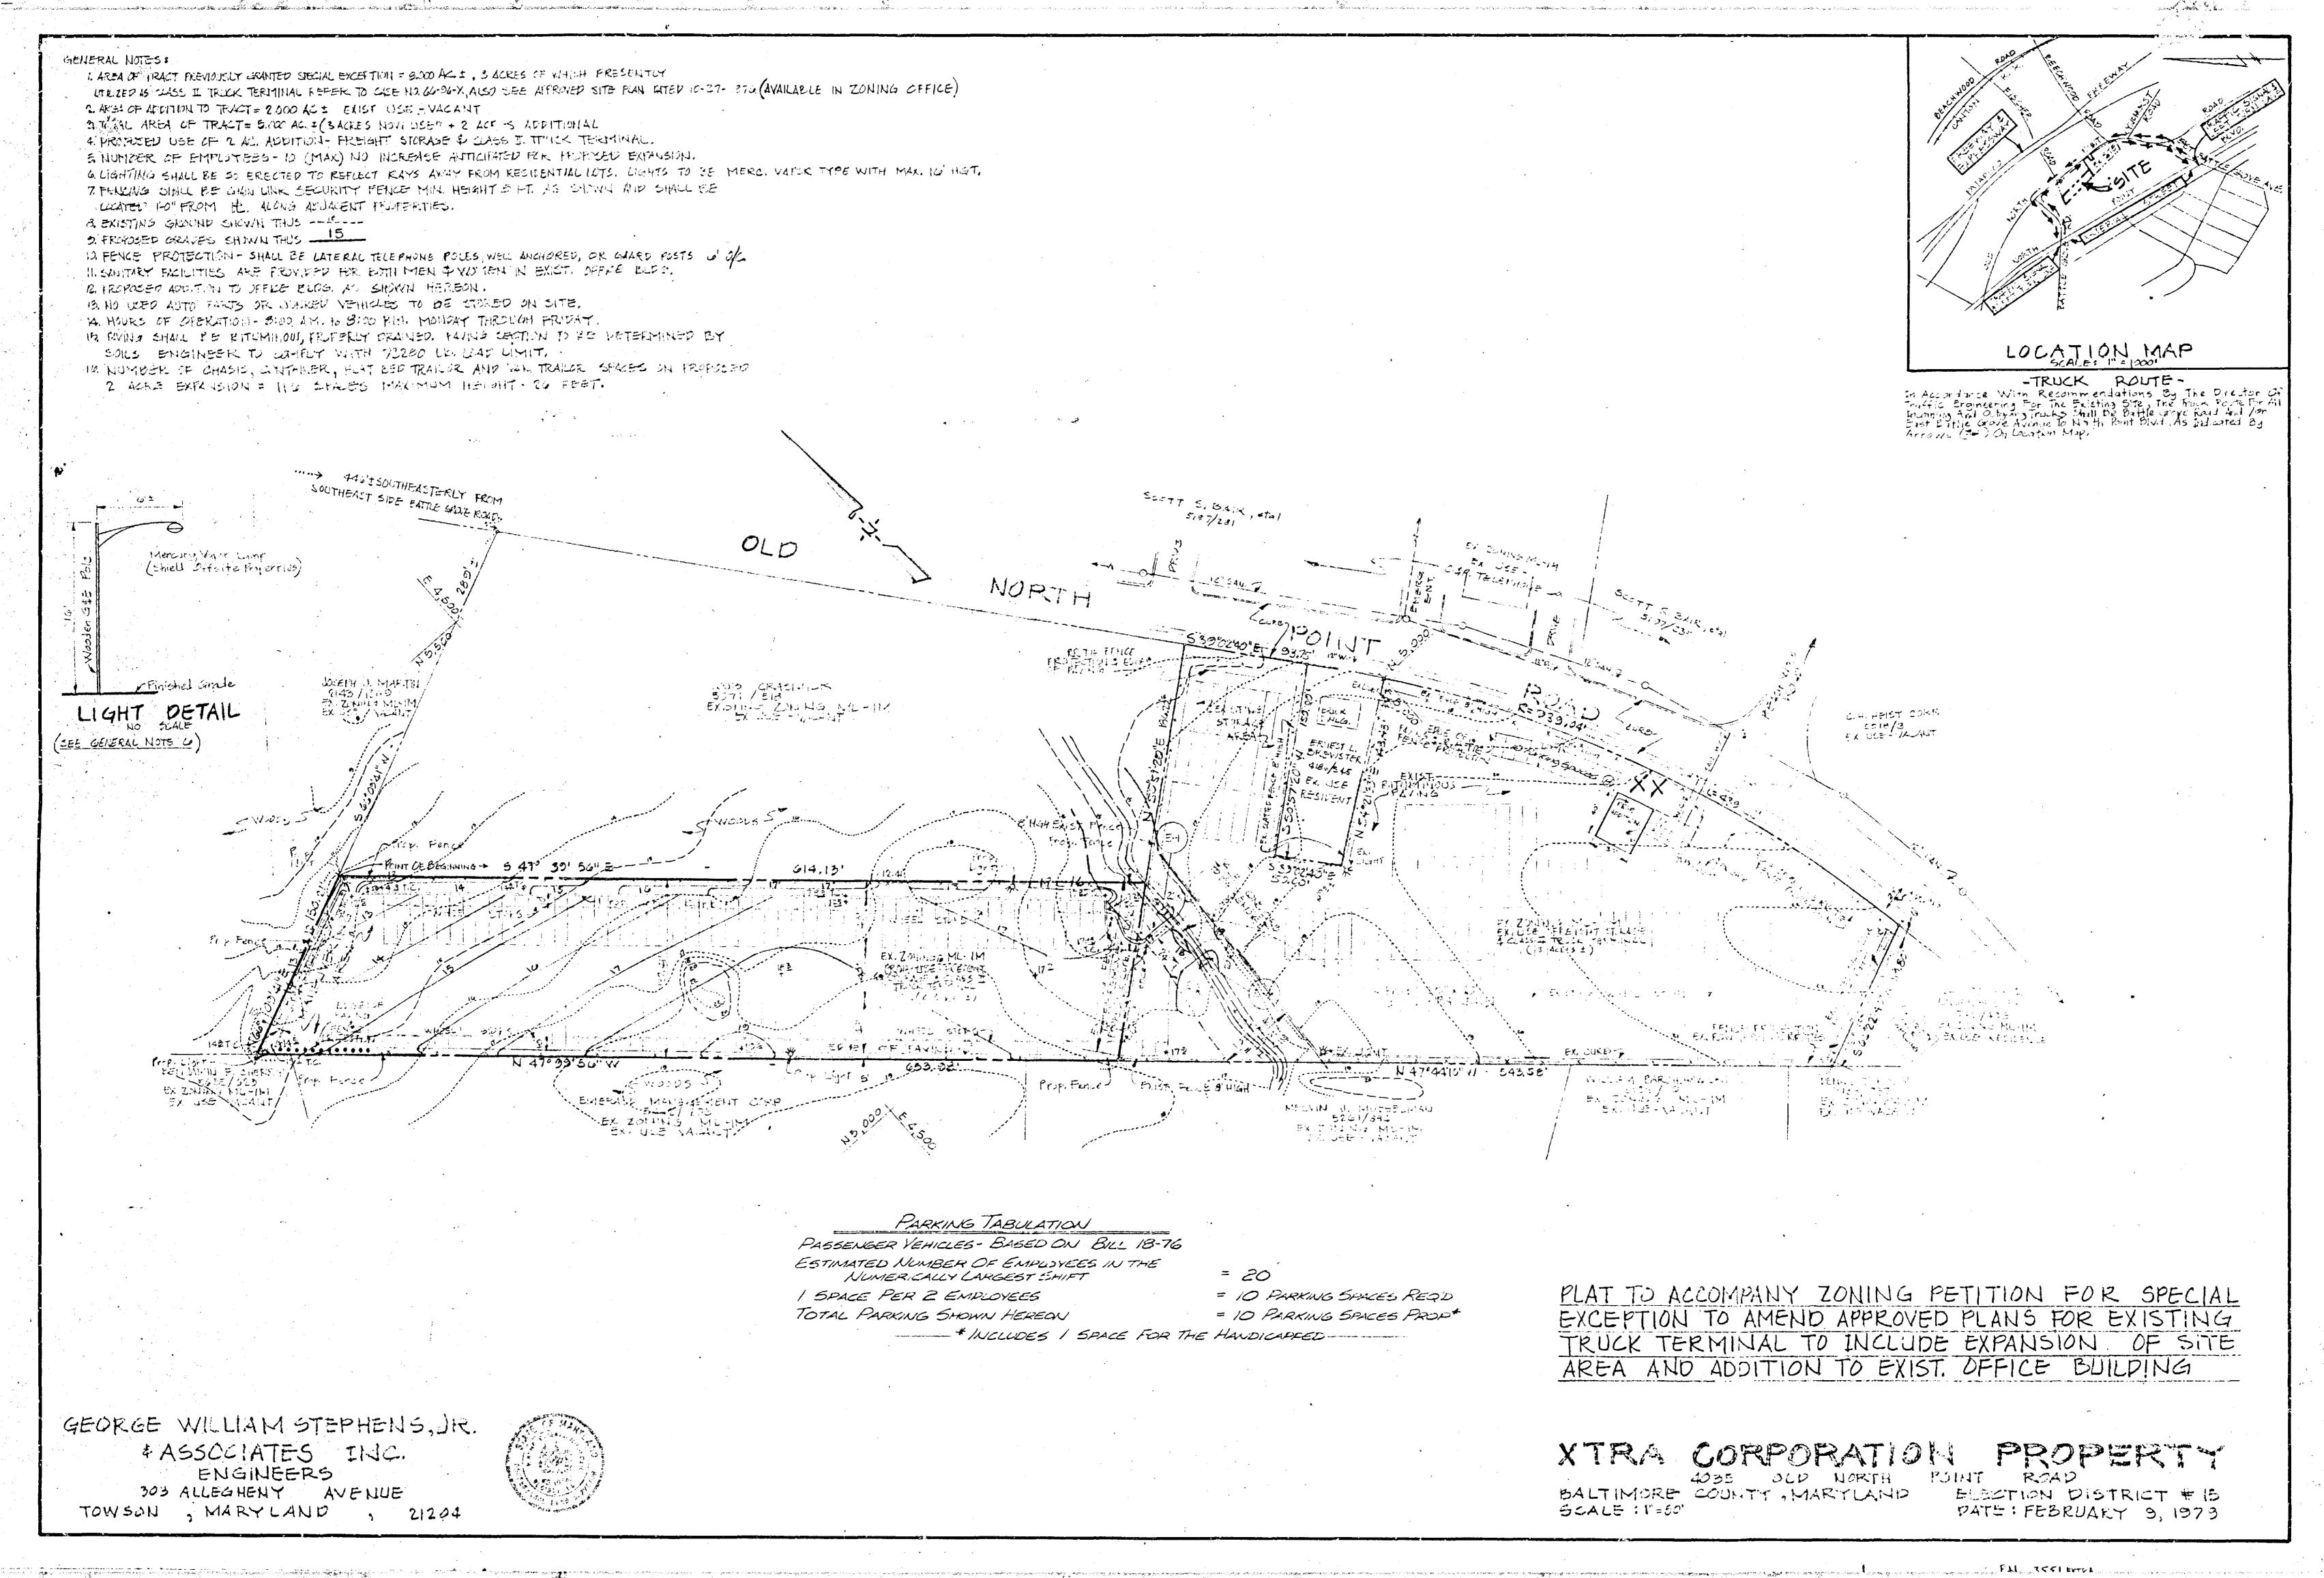

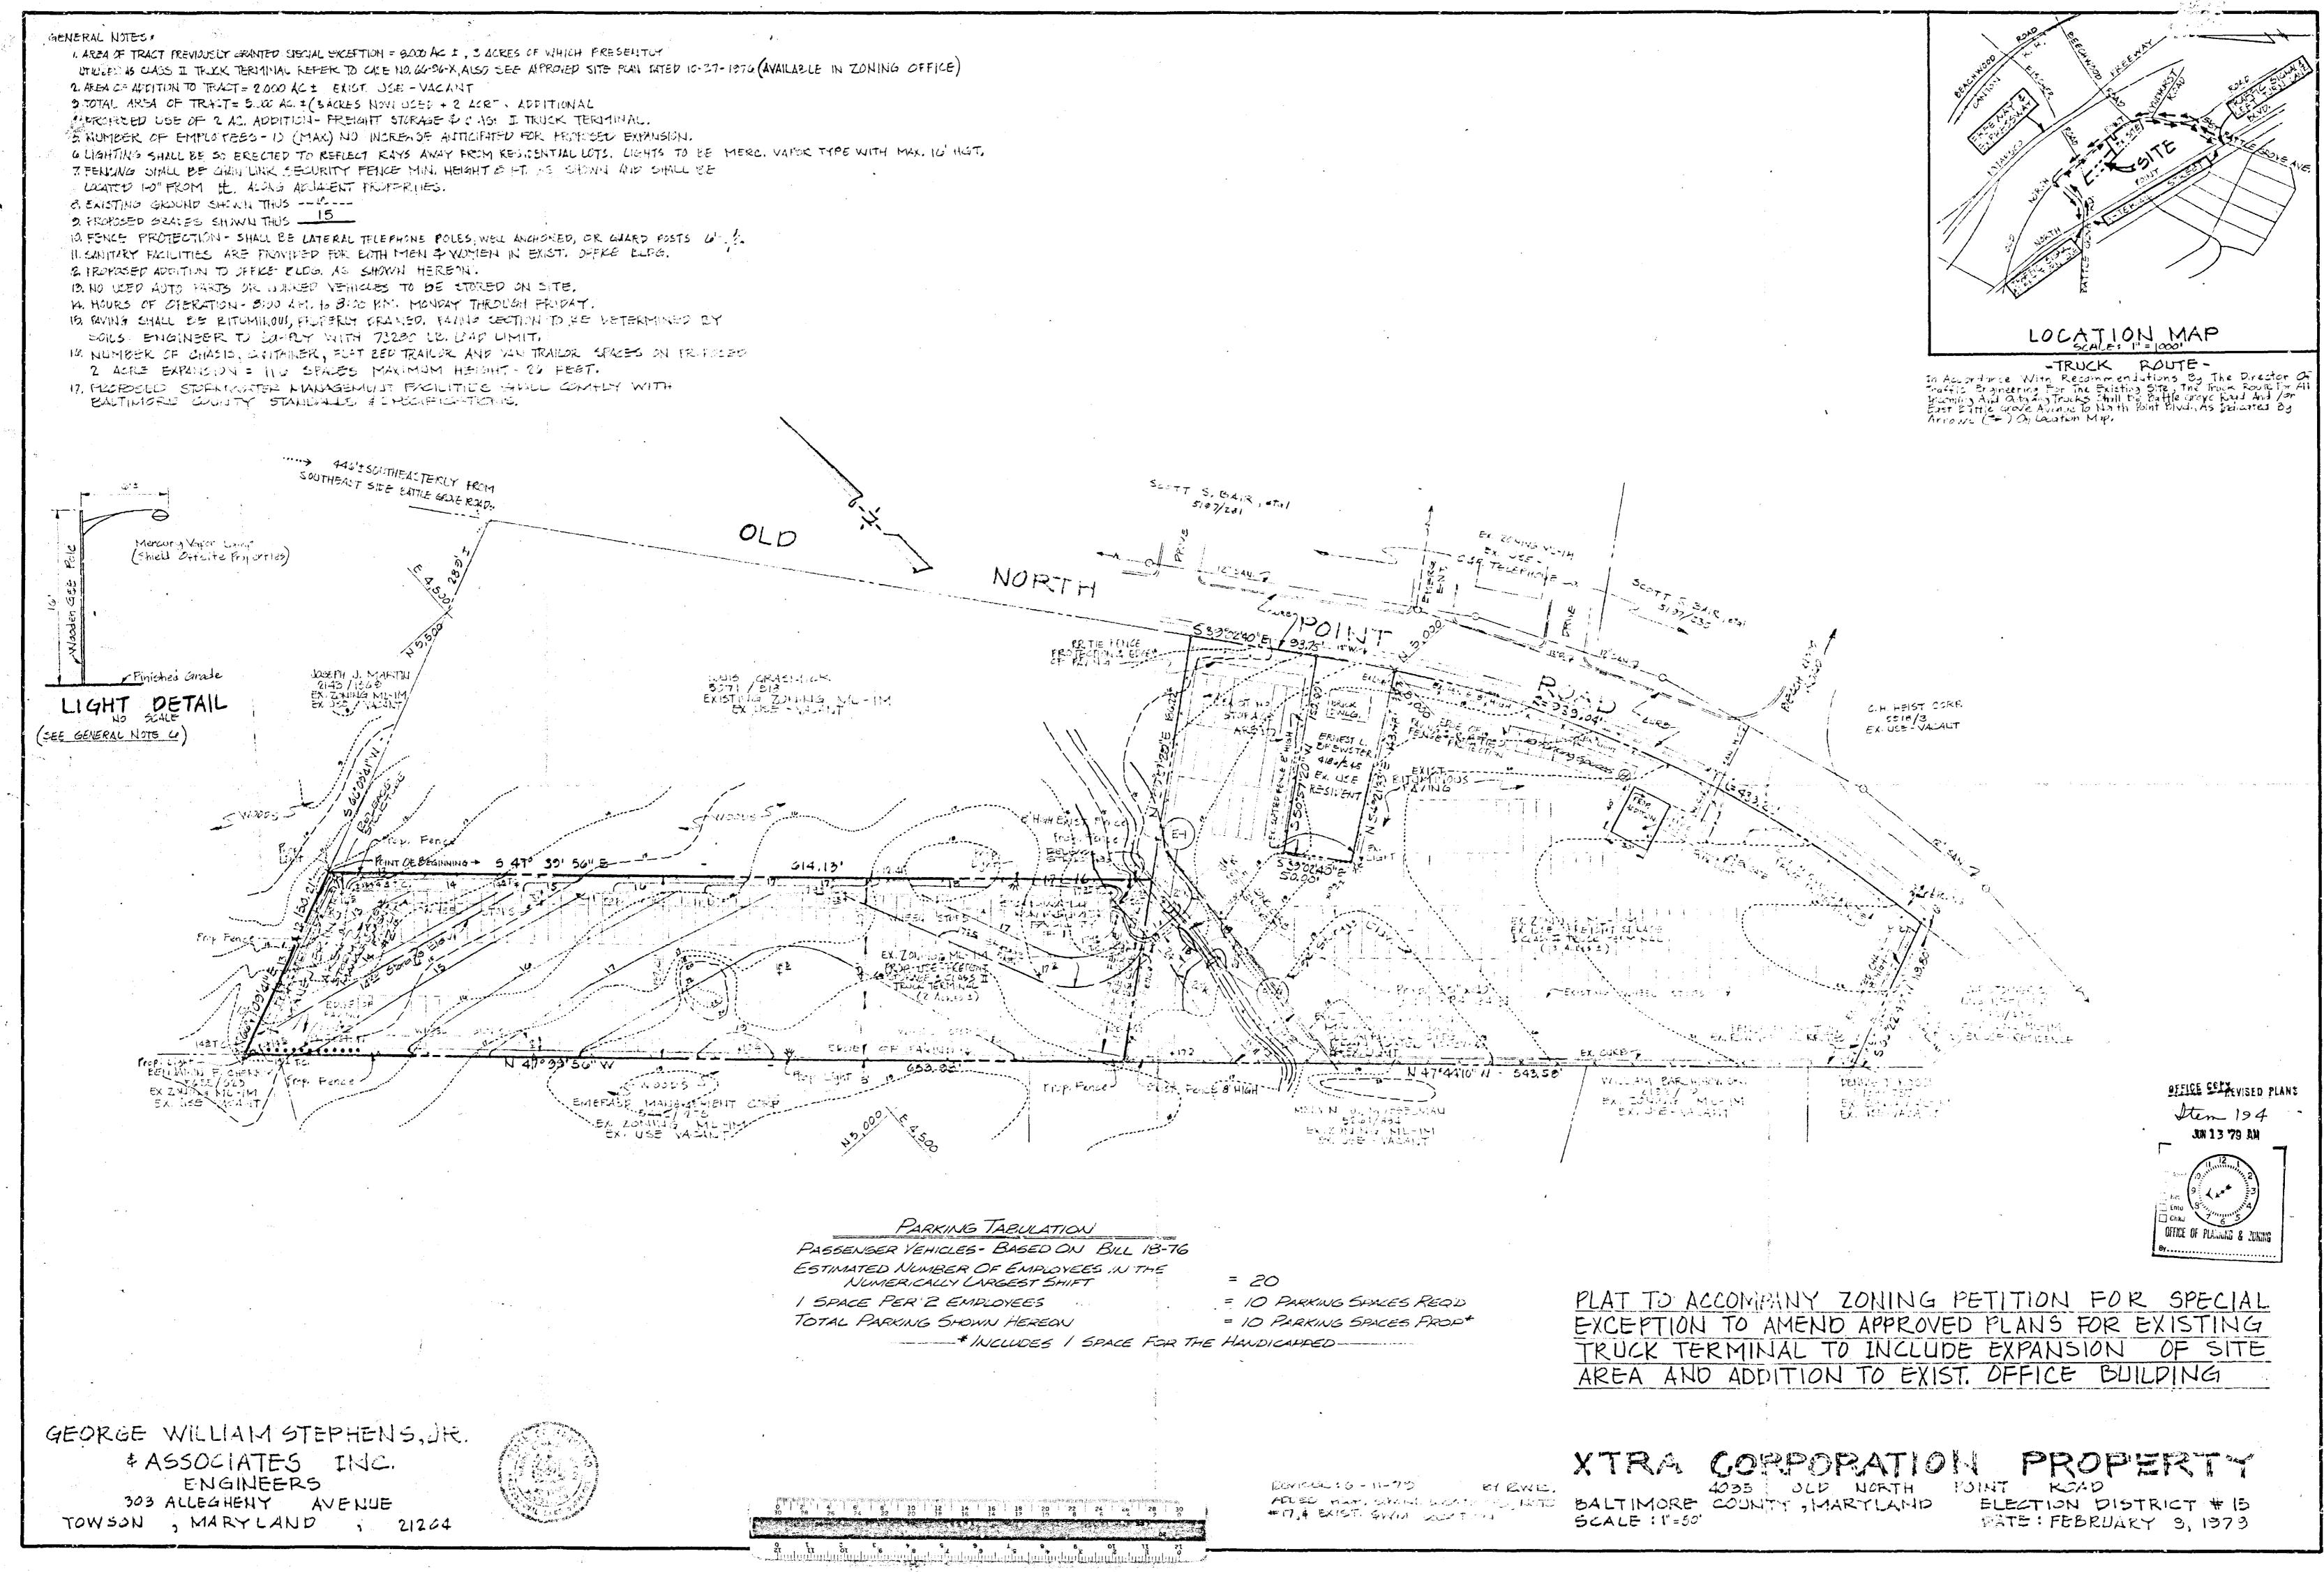

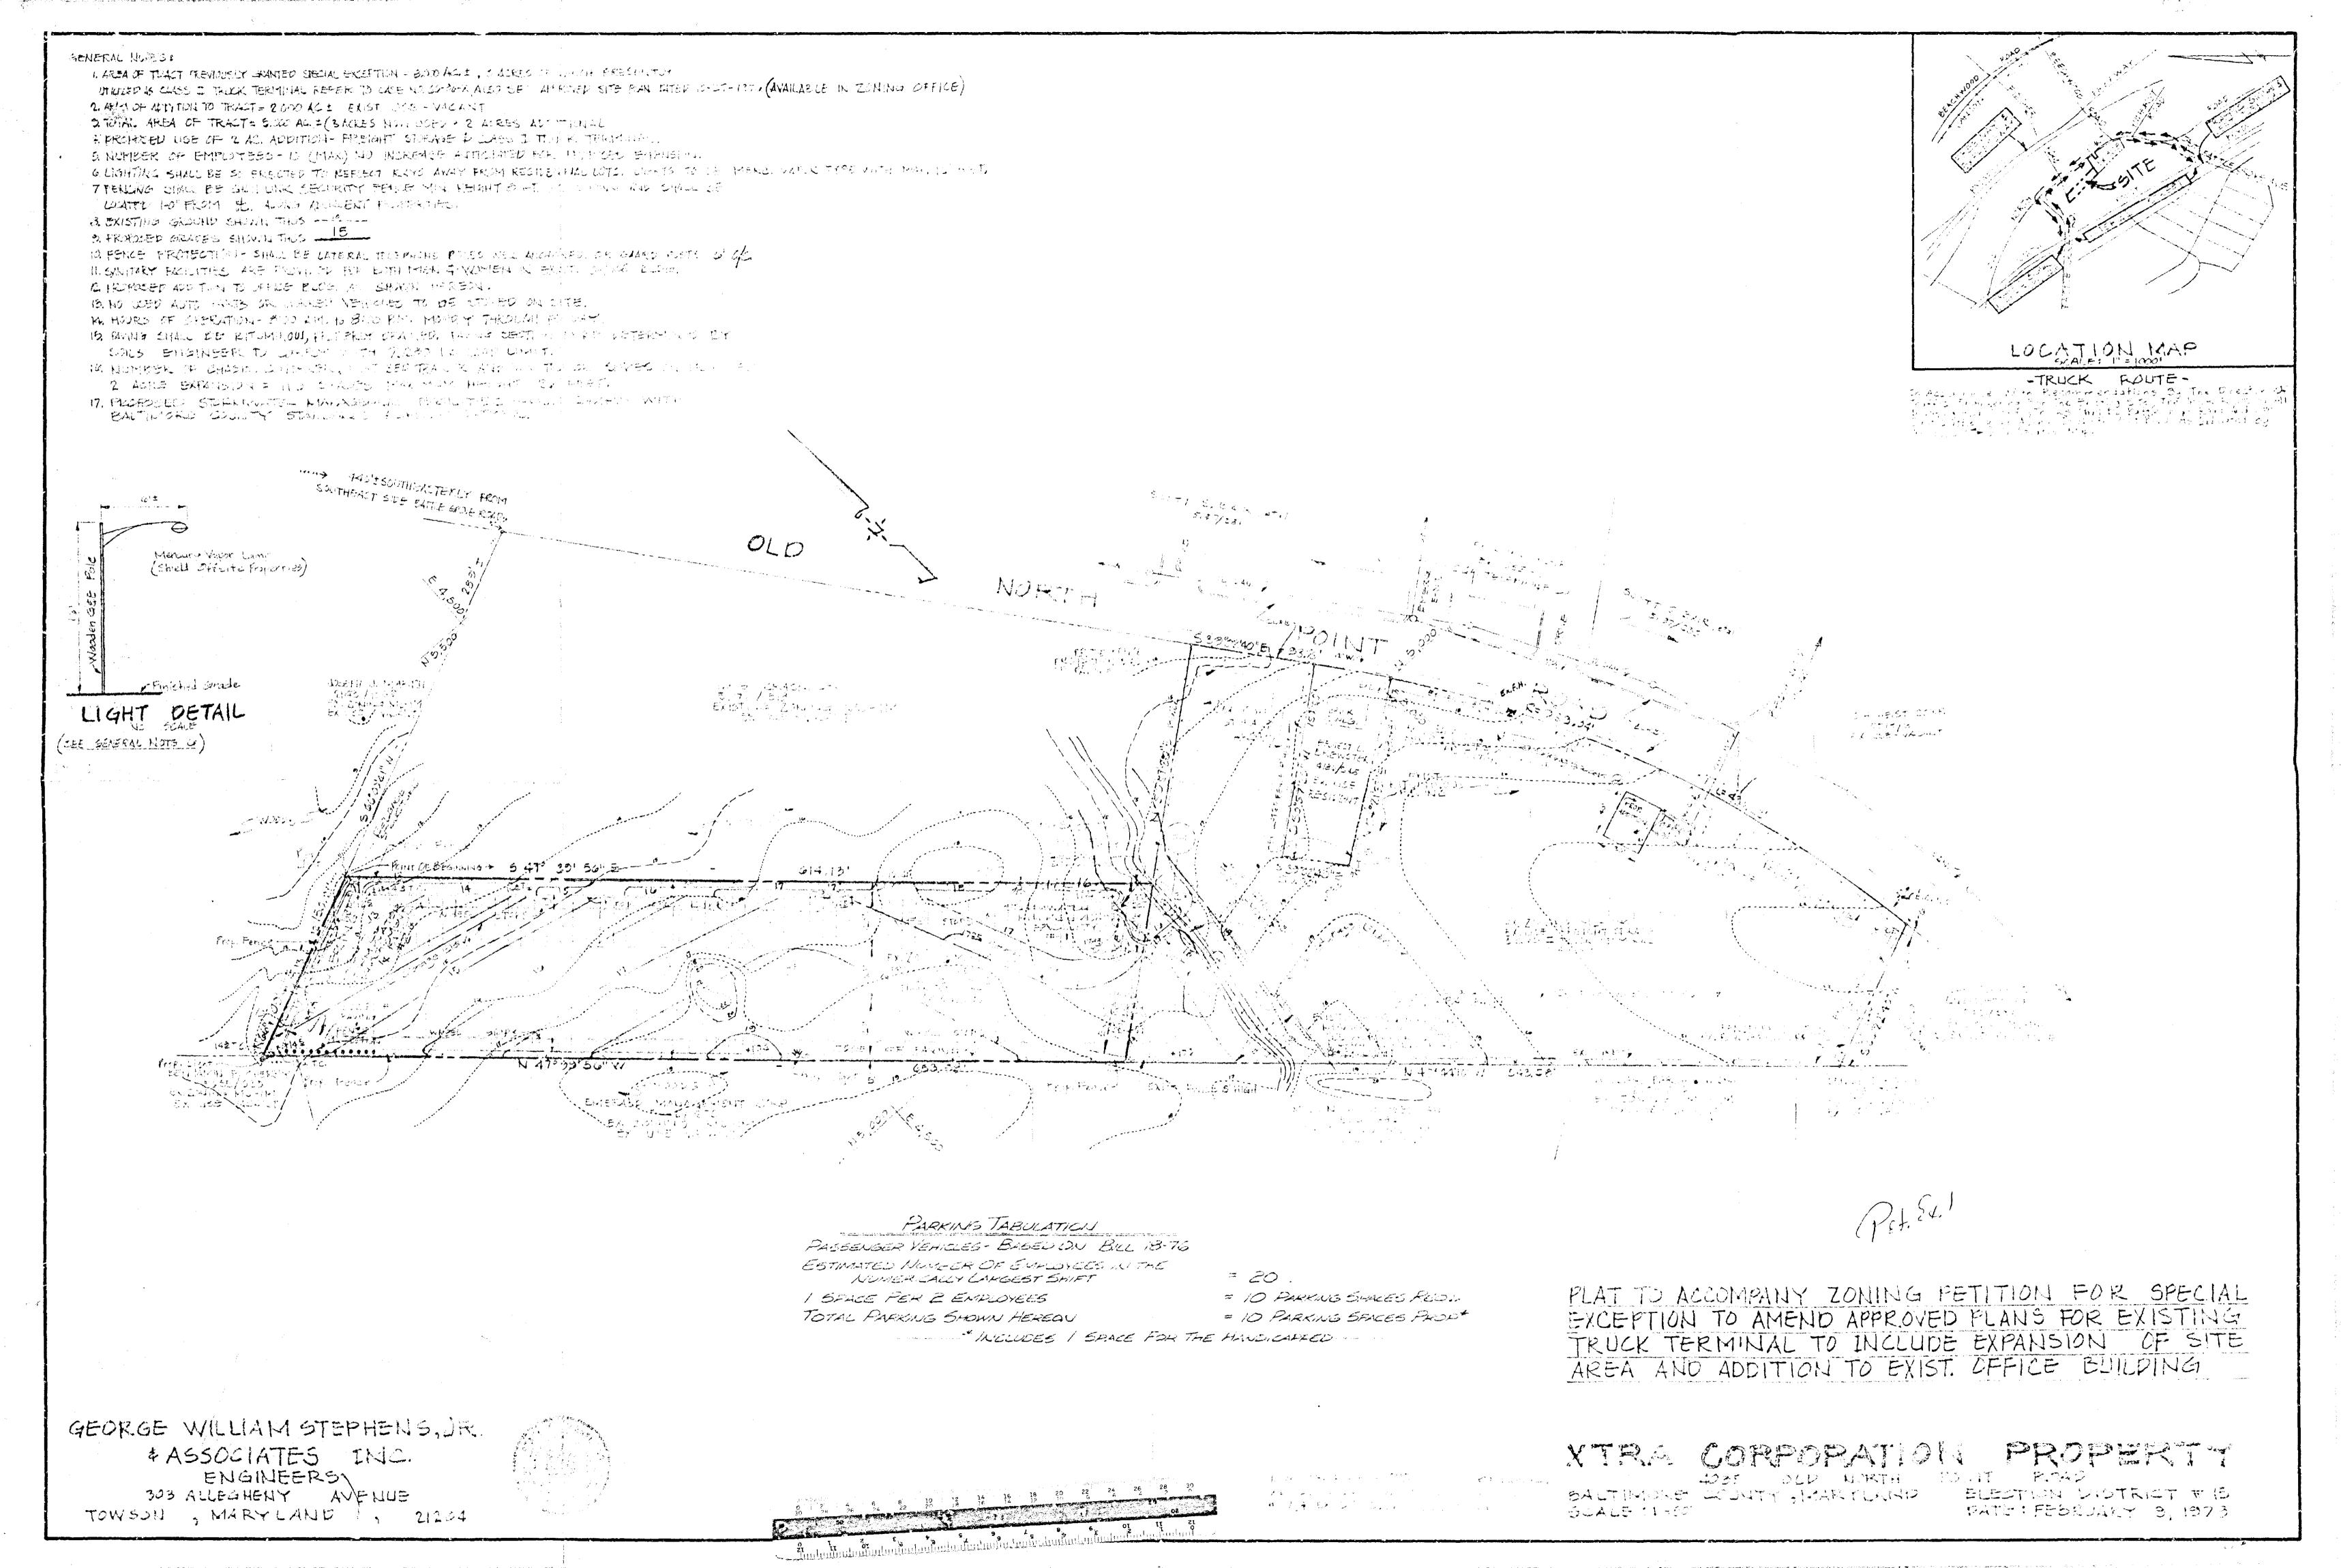



RE: PETITION FOR SPECIAL EXCEPTIONS : BEFORE THE ZONING TOMMISSIONER SW/S of Old North Point Rd., opposite Beachwood Rd. and Rischer Rd., 15th District OF BALTIMORE COLUTY

X-L CO., INC. and GRANOKE PROPERTIES, Petitioners

: Case 115. 80-9-X (Item 194)


#### :::::::

### ORDER TO ENTER APPEARANCE

Mr. Commissioner:

Pursuant to the authority contained in Section 524.1 of the Baltimore County Charter, I hereby enter my appearance in this proceeding. You are requested to notify me of any hearing date or dates which may be now or hereafter designated therefore, and of the passage of any preliminary or final Order in connection therewith.

Leter Max Temmerman Peter Max Zimmerman Deputy People's Counsel

w W. Deserand III John W. Hessian, III People's Counsel for Baltimore County County Office Building Towson, Maryland 21204

I HEREBY CERTIFY that on this 28th day of June, 1979, a cc. / of the aforegoing Order was mailed to Lawrence K. Ginsberg, Esquire, Cardin and Weinstein, P. A., 6615 Reisterstown Road, Baltimore, Maryland 21215, Attorney for Petitioners.

RE: PETITIONS FOR SPECIAL EXCEPTIONS: BEFORE THE SW/S of Old North Point Road, opposite ZONING COMMISSIONER Beachwood and Fischer Roads - 15th **Election District** X-L Company, Inc. and Granoke Properties - Petitioners NO. 80-9-X (Item No. 194) BALTIMORE COUNTY

::: ::: :::

The above entitled matter was set for hearing before the Zoning Commissioner, was posted and advertised in compliance with the Baltimore County Zoning Regulations, and was heard on Petitions for Special Exceptions for aniendments to the existing truck terminal site plan to allow expansion of the site area and to allow an addition to the existing office building.

:::

A review of the past history of the subject property discloses that in 1965 the then Deputy Zoning Commissioner, Edward D. Hardesty, granted a special exception under the then existing use regulations of the M.I.. Zone for a "Trucking Terminal", subject to restrictions as set forth in an Order dated November 17, 1965 (Case No. 66-96-X) and further subject to approval of the site plan by the State Roads Commission, the Bureau of Public Services, and the Office of Planning and Zoning. The Petition for Special Exception, the advertisement, and the site plan indicated the site was being proposed to be used as a truck terminal and referred to or delineated the tract as being 8.4 acres of land. The site plan, approved by G.E. Gavrelis on March 17, 1969 for the Office of Planning and Zoning, indicated the specifics, as to the comthements of the Zoning Office, the State Roads Commission, and the Planning Office, as being applicable to three acres of the total 8.4 acre parcel of ground covered by the survey description.

Subsequently, as the result of a zoning violation hearing (Case No. 576-225-V) before the then Zoning Commissioner, S. Eric DiNenna, an Order was signed on April 21, 1976, finding that violations of the Zor ng Regulations had occurred and required that a site plan be submitted and approved in accordance with "present day" regulations and that the property be improved

in accordance with said approved site plan. This Order was appealed to the County Board of Appeals of Baltimore County, which, by its Opinion dated September 23, 1976, opined that the special exception for the 8.4 acres "was utilized even though there was not strict compliance with the restrictions imposed upon the Special Exception. There is no language contained in the Zoning Regulations to imply that the enjoyment of a special exception will be lost by virtue of some abandonment after being utilized." The Board, however, affirmed the Zoning Commissioner's Order. There being no further appeal, the findings of the Board became final.

Having established the foundation upon which the subject property has been utilized since November 1965, the Zoning Regulations, in effect on the date of the Order granting the special exception for a truck terminal, become significant in view of the subsequent legislative changes effectuated in this type of land use. Commenserate therewith, Section 253.5 (1963 Zoning Regulations), Manufacturing, Light (M.L.) Zone, provided for "Truck Terminal" as a special exception and Section 101, Definitions (Amendment to 1963 Zoning Regulations by Bill No. 61, 1967), provided:

"Truck Terminal: Any building, other structure and/ or land devoted primarily to the transfer of merchandise from one truck or truck trailer to another or devoted to the lay-over parking of trucks or truck trailers. A truck terminal may include sleeping quarters for trucking personnel, recreation lounges and eating facilities for such personnel, other facilities to serve personnel or vehicles on the premises for the primary purpose of merchandise transfer or vehicle lay-over, and necessary incidental warehouse space for the storage of transitory freight."

Since the nomenclature, "Truck Terminal", was not subject to definition in the Zoning Regulations until the enactment of Bill No. 61, 1967, after the granting of the special exception, it would, therefore, appear that at the time of the November 1965 Order the extent of the use of said property as a truck terminal was not clearly delineated. In this regard, Webster's New Collegiate Dictionary, Second Edition, 1953, in defining "terminal" in a context applicable to transportation, states:

- 2 -

HIE

"Either end of a carrier line, as a railroad, trucking, or shipping line or airline, with classifying yards, docks and lighterage facilities, management offices, storage sheds, and freight-loading and passenger station."

Considering this definition, it appears that the special exception granted in 1965 did not provide for such use of the property, to wit, 8.4 acres, in the broader context established by the amendment to the Zoning Regulations in 1967 and thereby excludes sleeping quarters, recreation lounges, and eating facilities for trucking personnel.

In this regard, the Zoning Regulations remained in status quo until April 19, 1976, when Bill No. 18-76 took effect and changed the procedure. extent, and conditions of use and established classes of trucking facilities with definitions therefor, to wit, Class I and Class II. A review of the definition of Trucking facility, Class I (Section 101), is defined as being a trucking facility whose primary purpose is to accommodate the transfer of goods or chattels from trucks or truck trailers to other trucks or truck trailers in order to facilitate the transportation of goods and chattels, as distinguished from the definition of Trucking facility, Class II, whose primary purpose is to accommodate the parking or storage of trucks, truck trailers, or truck tractors. In this context, the site plan, as contained in Case No. 76-225-V, prepared and revised by George William Stephens, Jr., on August 27, 1976, and referred to in the Opinion of the Board as Defendant's Exhibit A, refers to the proposed use as being "freight storage yard and truck terminal" and indicates "combination chassis, container, flat bed trailer and van trailer storage area" to be located in the southwest area of the three acres, but nowhere on the site plan do the words "Class I" or "Class II" appear, in spite of the fact that Bill No. 18-76 had been in effect some four months before the last revision of the site plan on August 27, 1976. Irrespective of the absence of a designation as to the class of trucking facility conducted on the subject property, the verbage contained on the site plan leads one to the irrefutable

- 3 -

conclusion that the use comes within the purview of a Class II Trucking facility, as defined in Section 101 of the Zoning Regulations. (See also site plan prepared by George William Stephens, Jr. and Associates, Inc., revised October 28, 1976, and approved by required parties.) Having arrived at this conclusion, a discussion of the application of the pertinent sections of the "Trucking Facility" legislation become germaine to this Order.

To the extent that the subject site, to wit, three acres, as shown on the above referred to site plans, did not and does not comply in all respects to the applicable sections of the trucking facilities legislation, it exists by reason of the provisions of Section 410A.1B.3., to wit, "... Nonconformance with Subparagraph 410A.3.A.1 shall be allowed to stand if the site of the trucking facility does not abut a street on which access is permitted...or, if it does abut such a street, the County trucking-facilities-development officials determine that the length of the coextensive street line and site boundary is insufficient to permit proper access from that street...". (See site plan revised October 28, 1976, and approved by the County Trucking Facilities Development Officials Committee on October 26, 1976.) In this regard, a question immediately arises as to whether or not the nonconformance is limited to the area to which the site plan is applicable, to wit, three acres, or is applicable to the total 8.4 acres for which the original special exception was granted. This question becomes more significant in the interpretation and application of Sections 410A.1E.1. and 410A.1E.2. to the petitions filed, both of which limit the expansion to "that allowed under Section 104", to wit, no "...more than 25% of the ground floor area of buildings so used." To conlude that the nonconformance is limited to the three acres covered by the approved site plan and therefore expansion is limited to 25%, would, in my opinion, reflect upon the loga! rights obtained by the property owner when the effect of the conclusions reached by the Board in Case No. 76-225.V. There-

two acres of land originally a part of the total 8.4 acres granted a special exception, and to expand the office structure would not be in controvention of the intent of Bill No. 18-76 or Section 104. The same rational is applicable to dwellings within three hundred feet of a trucking facility, since the inability to comply existed for most of the 8.4 acres covered by the special exception from the date of its being granted, as well as from the effective date of Bill No. 18-76.

According to Section 410A.1F., "plans approved under this subsection: may be amended only by special exception", thereby establishing the burden of proof upon the Petitioner that the amendments to the site plan will not:

- "a. Be detrimental to the health, safety, or general welfare of the locality involved;
- b. Tend to create congestion in roads, streets or alleys therein;
- c. Create a potential hazard from fire, panic or other dangers;
- d. Tend to overcrowd land and cause undue concentration of population;
- e. Interfere with adequate provisions for schools, parks, water, sewerage, transportation or other public requirements, conveniences, or improve-
- f. Interfere with adequate light and air." (Section 502.1) and that the expansion would be in the interest of the general welfare of the community (Section 410A.1E.1.).

Testimony developed at the hearing by the Petitioner indicated that the purposes of the site plan amendments were two-fold:

- 1. To increase the size of the existing office area necessitated by increase in demand for space,
- 2. Increase in the acreage devoted to storage amounting to two acres along the southwestern property line necessitated by reason of demand for additional space to be devoted to those uses as provided by a Class II Trucking Facility.

SATE SATE

Conversely, testimony produced by the Protestants related generally to the methods of operation as not being in compliance with the site plan to the extent that the containers contained on the original three acres were stacked too high, that chassis were being stored on the property and available for lease, that the additional area for storage would increase the traffic in and out of the property onto Old North Point Road, a condition creating the use as being nonconforming, and the effect that the additional use would have on the newly to be constructed police station and on the surrounding community. There were no objections offered to the proposed increase in size of the exist-

After having considered all of the facts, testimony, and evidence offered by the Petitioners and the Protestants, it is the opinion of the Zoning Commissioner that the Petitioners have met the requirements established by Section 502.1 of the Baltimore County Zoning Regulations and the amendments to the Zoning Regulations by Bill No. 18-76; and, therefore,

ing office building.

FILING

FOR

CEIVED

REC

ORDER

DATE

IT IS ORDERED by the Zoning Commissioner of Baltimore County, this 6th day of February, 1980, that the herein Petition for Special Exception to amend the site plan to allow for an addition to the existing office building, in the manner and to the extent shown on the site plan prepared by George William Stephens, Jr. and Associates, Inc., dated February 9, 1979, and the herein Petition for Special Exception to amend the site plan to allow for the addition of two acres of land to the existing three acres of land presently in use as a Class II Trucking Facility, in the manner and to the extent shown on the aforementioned site plan, should be and the same are GRANTED, from and after the date of this Order, subject, however, to the following conditions and restrictions:

> 1. Compliance with each and every detail as shown and indicated on the site plan original ly approved by the County Trucking Facilities Development Officials Committee on October 26, 1976, except to the extent of the amendment by the special exception granted hereby.

2. Compliance with each and every detail as shown and indicated on the amended site plan filed herein, prepared by George William Stephens, Jr. and Associates, Inc., dated February 9, 1979, to the extent that it applies to the original site plan referred to in restriction No. I above, by the addition to the existing office building.

- 3. Compliance with Sections 410A.3A., B., and C. of the Zoning Regulations, except to the existing nonconformance relating to
- 4. No containers shall be stacked within the "setback" areas provided for in the Zoning Regulations for the erection of a structure or building and no containers shall be stacked in excess of two containers in height outside of that area hereinabove referred to as "setback" areas in either the original three acre area or in the two acre additional area.
- 5. Compliance with the comments of the Maryland Department of Transportation, dated March 23, 1979, as such comments relate to storm water management.
- 6. Hours of operation during weekdays shall be between 8:00 a.m. and 5:00 p.m.
- 7. Approval of a site plan by the County Trucking Facilities Development Officials Committee, the Department of Public Works, the State Highway Administration, and the Office of Planning and Zoning.

Zonirg Commissioner of

Baltimore County

FILMS FOR CEIVED

ORT DAT

- 4 -

fore, it is my opinion that to expand the site, so as to include the addition of

- 5 -

- 6 -

===

ORDER

\_ ? \_

The same

BALTIMORE COUNTY

**ZONING PLANS** 

ADVISORY COMMITTEE



PETITION AND SITE PLAN

BALTIMORE COUNTY, MARYLAND

INTER-OFFICE CORRESPONDENCE

Zoning Advisory Committee FROM\_ Sharon Caplan

Industrial Development Commission

Nicholas B. Commodari

SUBJECT. Item No. 194 - Property Owner: X-L Co., Inc. & Granoke Properties Location: 289' SW Old North Point Rd. 446' SE of Battle Grove Road

Existing Zoning: M. L. -I. M. Proposed Zoning: Special Exception to amend the

existing truck terminal site plan to allow an addition to the existing office building.

March 20, 1979

In recognition of Baltimore County's desire to foster a healthy economic growth, we request the Zoning Officer to evaluate the above request in the best interest of industrial expansion.

SC:pk

Lawrence K. Ginsberg, Esquire 6615 Reisterstown Road Balt nore, Maryland 21215

CC: George W. Stephens, Jr. & Associates, Inc. 303 Allegheny Avenue Towson, Maryland 21204

BALTIMORE COUNTY OFFICE OF PLANNING & ZONING

County Office Building 111 W. Chesapeake Ave. Towson, Maryland 21204

Your Petition has been received and accepted for filing

this 8th day of May

S. ERIC DI NENNA Zoning Commissioner

X-L-Co, Inc. Petitioner and Granoke Properties

Petitioner's Attorney Ginsberg, Esq.

Chairman, Zoning Plans Advisory Committee

BALTIMORE COUNTY ZONING PLANS ADVISORY COMMITTEE

June 26, 1979

COUNTY OFFICE BLF: lil W. Chesapeake Ave. Towson, Maryland 21204

Nicholas B. Commodari Chairman

Bureau of Department of Traffic Engineering State Roads Commission

uurea 1 of Fire Prevention Bealth Department Project Planning Building Department Board of Education Zoning Administration Industrial

Lawrence K. Ginsberg, Esquire 6615 Reisterstown Road Baltimore, Maryland 21215

> RE: Item No. 194 Petitioners - X-L-Co., Inc. and Granoke Properties Special Exception Petition

Dear Mr. Ginsberg:

The Zoning Plans Advisory Committee has reviewed the plans submitted with the above referenced petition. The following comments are not intended to indicate the appropriateness of the zoning action requested, but to assure that all parties are made aware of plans or problems with regard to the development plans that may have a bearing on this case. The Director of Planning may file a written report with the Zoning Commis sioner with recommendations as to the suitability of the requested zoning.

The subjects of this petition represent two parcels of ground, presently under separate ownership. The first parcel, owned by X-L-Co., Inc., is located on the west side of Old North Point Road directly opposite its intersection with Beechwood Road in the 15th Election District. Said parcel is presently improved with the facilities of a trucking facility, which include parking and storage of tractortrailers and containers, and an existing office building. This existing facility was approved in accordance with the applicable requirements of Bill No. 18-76, which pertains solely to trucking facilities. Because of your clients' proposal to construct an addition to the existing office building, and, thereby, revise the approved plan, the Special Exception for this particular parcel is required. The second parcel, which is immediately adjacent to the X-L property, is owned by Granoke Properties and consists of vacant wooded land. This site, as well as the former parcel, is part of a larger tract of land which was granted a Special Exception as a result of Case No. 66-96-X. Because this particular parcel of ground was not included on the approved plan, this Special Exception to amend said plan by increasing the truck storage area is required.

Item No. 194 Page 2 June 26, 1979

It should be noted that these two parcels of ground, as well as the parcel owned by Louis Grasmick, as shown on the submitted site plan, were the subject of a subsequent zoning violation (Case No. 76-225-V). As a result of this hearing, it was determined by the then Zoning Commissioner, Mr. S. Eric DiNenna, that the previous Special Exception was still valid for the entire property.

In response to the comments of the Office of Current Planning, it should be noted that if this petition is granted, the plan must be approved by the trucking committee and satisfy all applicable requirements of the aforementioned Bill No. 18-76.

Enclosed are all comments submitted from the Committee to this office. The remaining members felt that no comment was warranted. This petition is accepted for filing on the date of the enclosed filing certificate. Notice of the hearing date and time, which will be held not less than 30 nor more than 90 days after the date on the filing certificate, will be forwarded to you in the near future.

Zoning Plans Advisory Committee

NBC:nr

Enclosures

cc: George W. Stephens, Jr. & Associates, Inc. 303 Allegheny Avenue Towson, Maryland 21204

department of public works

THORNTON M. MOURING, P.E.

May 8, 1979

Mr. S. Eric DiNenna Zoning Commissioner County Office Building Towson, Maryland 21204

> Re: Item #194 (1978-1979) Property Owner: X-L Co., Inc. & Granoke Properties 289' S/W Old North Point Rd. 446' S/E of Battle Grove Rd. Existing Zoning: M.L.-I.M. Proposed Zoning: Special Exception to amend the existing truck terminal site plan to allow an addition to the existing office building.

Dear Mr. DiNenna:

The following comments are furnished in regard to the plat submitted to this office for review by the Zoning Advisory Committee in connection with the subject item.

Acres: 5.00 District: 15th

Subdivision of property within Baltimore County is subject to Baltimore County Subdivision Regulations.

Highways:

Old North Point Road (Md. 20) is a State Road; therefore, all improvements, intersections, entrances and drainage requirements as they affect the road come under the jurisdiction of the Maryland State Highway Administration. Any utility construction within the State Road right-of-way will be subject to the standards, specifications and approval of the State in addition to those of Baltimore County.

Sediment Control:

Development of this property through stripping, grading and stabilization could result in a sediment pollution problem, damaging private and public holdings downstream of the property. A grading permit is, therefore, necessary for all grading, including the stripping of top soil.

Drainage studies, storm water management drawings and sediment control drawings will be necessary to be reviewed and approved prior to the recording of any record plat or the issuance of any grading or building permits.

Item #194 (1978-1979) Property Owner: X-L Co., Inc. & Granoke Properties Page 2 May 8, 1979

Storm Drains:

In accordance with the drainage policy, the Fetitioner is responsible for the total actual cost of drainage facilities required to carry the storm water run-off through the property to be developed to a suitable outfall.

Storm drains, which will be required in connection with any further development of this property, are to be designed and constructed in accordance with Baltimore County Standards and Specifications.

Open stream drainage requires a drainage reservation or easement of sufficient width to cover the flood plain of a 100-year design storm. However, a minimum width of 50 feet is required.

The Petitioner must provide necessary drainage facilities (temporary or permanent) to prevent creating any nuisances or damages to adjacent properties, especially by the concentration of surface waters. Correction of any problem which may result, due to improper grading or improper installation of drainage facilities, would be the full responsibility of the Petitioner.

Water and Sanitary Sewer:

A public 12-inch water main and public 12 and 18-inch sanitary sewerage exist

ELLSWORTH N. DIVER, P.E.

END: EAM: FWR: ss

cc: J. Wimbley D. Grise

E-NW & SW Key Sheets 9 & 10 SE 28 & 29 Pos. Sheets NE 3 G & H Topo 104 Tax Map

Maryland Department of Transportation

M. S. Caltrider

March 23, 1979

Mr. S. Eric DiNenna Zoning Commissioner County Office Fldg. Towson, Md. 21204

Attention: Mr. N. Commodari

Re: Z.A.C. Meeting, March 20, 1979 Item: 194 Property Owner: X-L Co., Inc. & Granoke Properties Location: 289' SW Old North Point Road

(Rte. 20) 446' SE of Battle Grove Road. Existing Zoning: M.L.-I.M. Proposed Zoning: Special Exception to

amend the existing truck terminal site plan to allow an addition to the existing office bldg.

Acres: 5.00 District: 15th

Dear Mr. DiNenna:

The existing entrance is acceptable, however, the plan indicates no provision for storm water management. Storm water management should be provided to accommodate a 100 year frequency storm. The plan must indicate the location of the storm water management structure. The plan must be revised prior to a hearing date being assigned.

CL:JEM:dj

Very truly yours,

Charles Lee, Chief Bureau of Engineering Access Permits

By: John E. Meders

My telephone number is 383-4320

P.U. Box 717 / 309 West Preston Street, Baltimore, Maryland 21203

LESLIE H. GRAEF


June 14, 1979

Mr. William Hammond, Zoning Commissioner Zoning Advisory Committee Office of Planning and Zoning Baltimore County Office Building Towson, Maryland 21204

Dear Mr. Hammond:

fire department

(301) 825-7310

Paul H. Reincke

TOWSON, MARYLAND 21204

Office of Planning and Zoning Baltimore County Office Building

Attention: N. Commodari, Chairman

Zoning Advisory Committee

Ro: Property Owner: X-I. Co., Inc. & Granoke Properties

Location: 289' SW Old North Point Rd. 446' SE of Battle Grove Rd.

Pursuant to your request, the referenced property has been surveyed by this Bureau and the comments below marked with an "x" are applicable and required

(x) 1. Fire hydrants for the referenced property are required and shall be located at intervals or 300 feet along an approved road in accordance with Baltimore County Standards as published by the Department of Public Morks. Fire hydrant should be located

to be corrected or incorporated into the final plans for the property.

at Old North Point Road and Beach.

() 2. A second means of vehicle access is required for the site.

EXCLEDS the maximum allowed by the Fire Department

( ) 7. The Fire Provention Bureau has no comments, at this time.

( ) 4. The site shall be made to comply with all applicable parts of the

(x) 5. The buildings and structures existing or proposed on the site shall

Fire Prevention Code prior to occupancy or beginning of operations.

comply with all applicable requirements of the National Fire Protection Association Standard No. 101 "Life Safety Code", 1976

( ) 3. The vehicle dead end condition shown at \_\_\_\_

Edition prior to occupancy.

( ) 6. Site plans are approved as drawn.

Towson, Maryland 21204

Item No. 194

Gentlemen:

Comments on Item #194, Zoning Advisory Committee Meeting, March 20, 1979, are as follows:

Property Owner: X-L Co., Inc and Granoke Properties Location: 289' SW Old North Point Road 446' SE of Battle Crove Road Existing Zoning: M.L.-I.M. Proposed Zoning: Special Exception to amend the existing truck terminal site plan to allow an addition to the existing office building Acres: 5.00 District: 15th

This office has reviewed the subject petition and offers the following comments. These comments are not intended to indicate the appropriateness of the zoning in question, but arr to assure that all parties are made aware of plans or problems with regard to development plans that may have a bearing on this petition.

A cross section of the paving and wheel stops should be indicated on the site plan.

The subdivision requirements must be complied with.

Very truly yours,

March 29, 1979

Zoning Agonda Meeting of 3/20/79

Planner III Current Planning and Development

department of traffic engineering TOWSON, MARYLAND 21204 (301) 494-3550 STEPHEN E. COLLING

April 5, 1979

Mr. S. Eric DiNenna Zoning Commissioner County Office Building Towson, Maryland 21204

> - ZAC - March 20, 1979 Location: Existing Zoning:

Property Owner: X-L Co., Inc. & Granoke Properties 299' SW Old North Point Rd. 446' SE of Battle Grove Rd.

M.L.-I.M. Proposed Zoning: Special Exception to amend the existing truck terminal site plan to allow an addition to the existing office building.

Acres: 5.00 District: 15th

Dear Mr. DiNenna:

The proposed special exception to amend the existing truck terminal to allow an addition to the office is not expected to cause any major traffic problems.

> Very truly yours, Michael S. Flanigun Engineer Associate II

MSF/mjm

battimare countr department of permits and licenses TOWSON, MARYLAND 21204 (301) 494 3610

JOHNO SEYFFERT

DIRECTOR

Mr. S. Eric DiNenna, Zoning Commissioner Office of Planning and Loning County Office Building Towson, Maryland 21204

Dear Mr. DiNenna;

289' SW Old North Point Road 446' SE of Battle Grove Road

allow an addition to the existing office building.

District: 15th

X A. Structure shall conform to Baltimore County Building Code (B.O.C.A.)

C. Additional Permits shall be required.

D. Building shall be upgraded to new use - requires alteration permit.

application for a building permit.

Architect or Engineer's original seal will be required to file an application for a building permit.

Plans Review Chief

baltimore county

TOWSON, MARYLAND 21204

DONALD J. ROOP, M.D., M.P.H.

DEPUTY STATE AND COUNTY HEALTH OFFICER

Mr. S. Eric DiNenna, Zoning Commissioner

Existing Zoning: M.L.-I.M.

15th

Office of Planning and Zoning

County Office Building

Towson, Maryland 21204

20, 1979, are as follows:

Acres:

material.

IJF/JRP/fth &

cc: W. L. Phillips

District:

storm water management for this site.

Dear Mr. DiNenna:

department of health

March 23, 1979

Comments on Item # 191, Zoning Advisory Committee Meeting, March 20, 1979

Property Owner: X-L Co., Inc & Granoke Properties

Proposed Zoning: Special Exception to amend the existing truck terminal site plan to

The items checked below are applicable:

1970 Edition and the 1971 Supplement, State of Maryland Code for the Handicapped and aged and other applicable codes.

X B. A building permit shall be required before construction can begin.

E. Three sets of construction drawings will be required to file an

X F. Three sets of construction drawings with a registered Maryland

G. Wood frame walls are not permitted within 3'0" of a property line. Contest Building Department if distance is between 3'0" and 6'0"

H. Requested setback variance conflicts with the Baltimore County Building Code. See Section

I. No Comment.

J. Comment:

Charles E. Burnham

LAW OFFICES CARDIN and WEINSTEIN, P. A 6615 REISTERSTOWN ROAD SUITE 301 BALTIMORE, MARYLAND 21215 (301) 358-7411

TOWSON, MD. OFFICE SUITE 500 TOWSON, MD. 21204

1025 CONNECTICUT AVE., N. W. SHITE 911 WASHINGTON, D.C. 20036 (202) 466-8010

LAWRENCE K. GINSBERG HOWARD C. WEINSTEIN DAV'D A. KUNTZ

JEROME 5, CARDIN

WILLIAM I. WEINSTEIN

JACOBILL CANDIN OF COUNSEL \*HEMBER D.C. BAR

August 27, 1980

Ms. Muriel E. Budaemeier Baltimore County Board of Appeals Room 219 Court House Towson, Maryland 21204

Re: X-L Company, Inc. and Granoke Properties, Zoning Case #80-9-X

Dear Ms. Buddemeier:

I would appreciate if you would set the above captioned case in for Hearing as quickly as possible. Since the parties have worked out an agreement, it should be a short Hearing with brief testimony, at which time an agreed Order would be submitted to the Board.

Thanking you for your immediate attention and any help you could give us in obtaining a prompt Hearing to conclude this matter would be greatly appreciated.

Very truly yours, Lawrence K. Ginsbern

cc: Peter Max Zimmerman Deputy People's Counsel

494-3180

County Board of Appeals Room 219, Court House

Sept. 3, 1980

NOTICE OF ASSIGNMENT

Towson, Maryland 21204

NO POSTPONEMENTS WILL BE GRANTED WITHOUT GOOD AND SUFFICIENT REASONS. REQUESTS FOR POSTPONEMENTS MUST BE IN WRITING AND IN STRICT COMPLIANCE WITH BOARD RULE 2(b). ABSOLUTELY NO POSTPONE-MENTS WILL BE GRANTED WITHIN FIFTEEN (15) DAYS OF SCHEDULED HEAR-ING DATE IN ACCORDANCE WITH RULE 2(c), COUNTY COUNCIL BILL #108

CASE NO. 80-9-X

X-L COMPANY, INC. and GRANOKE PROPERTIES

SE-Amendment to existing truck terminal site plan to allow expansion of site area and also to allow addition to existing office building

SW/S Old North Point Road, opposite Beachwood and Fischer Roads

15th District

2/6/80 - Z.C. GRANTED PETITIONS, subject to restrictions

ASSIGNED FOR:

THURSDAY, OCTOBER 23, 1980 at 10 a.m.

cc: Lawrence K. Ginsberg, Esq. X-L Company, Inc.

Petitioner Granoke Properties Protestant

Mrs. Marjorie Hill, President Wells McComas Citizens Improvement Assn., Inc.

John W. Hessian, III, Esq. Mr. J. E. Dyer

Mr. W. E. Hammond Mr. J. Hoswell

Counsel for Petitioners

People's Counsel

Edith T. Eisenhart, Adm. Secretary

4/28/80 - Notified the following of scheduled hearing for WED., JUNE 11, 180, at 10 a.m.:

Atty, for petitioners Lawrence K. Ginsberg, Esq. X-L Co. Petitioner

May 7, 1979

289' SW Old North Point Rd. 446' SE of Battle Grove Rd.

Ian J. Forrest, Acting Director

BUREAU OF ENVIRONMENTAL SERVICES

terminal site plan to allow an addition to the

Comments on Item #194, Zoning Advisory Committee Meeting of March

Proposed Zoning: Special Exception to amend the existing truck

existing office building.

The parking area/s should be surfaced with a dustless, bonding

The addition of 2 acres of impervious surface should necessitate

No construction work should be done within the 100 year floodplain.

Property Owner: X-L Co., Inc. & Granoke Properties

Granoke Properties Marjorie Hill J. W. Hessian J. E. Dyer

9/3/80 - Above notified of scheduled hearing for THURSDAY, OCTOBER 23, 1980 at 10 a.m.

10/23/80 - Per J.V. Murphy - Mr. Zimmerman and Mr. Ginsberg to submit a Joint Memo within one week.

W. Hammond

Jas. Hoswell